

Ellsworth


Form 51-5M-2-29-34703

Map No. **KANSAS** Sec. 22 Twp. 16 R. 10<sup>w</sup>

Well No. 1-Holtenburg Farm

Beardmore et al Company

NORTH

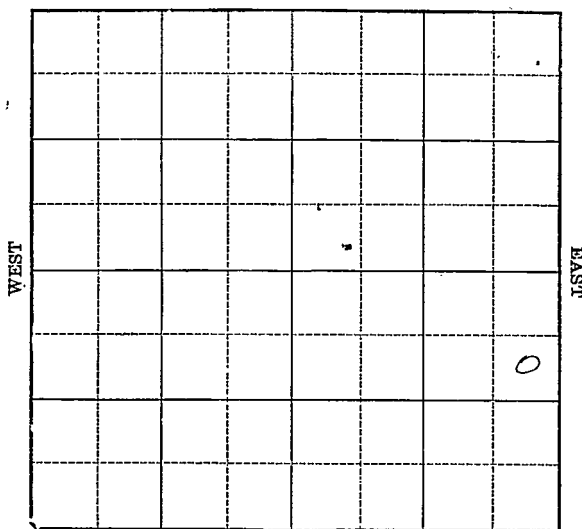

SOUTH

Location \_\_\_\_\_

Drilling Remarks \_\_\_\_\_

\_\_\_\_\_

\_\_\_\_\_

### RECORD

Cased \_\_\_\_\_ in. \_\_\_\_\_ ft.

Sand \_\_\_\_\_

Gas \_\_\_\_\_

Oil \_\_\_\_\_

Total Depth \_\_\_\_\_

Rig Up \_\_\_\_\_

Drilling Remarks \_\_\_\_\_

\_\_\_\_\_

\_\_\_\_\_

### PRODUCTION

1st 24 hrs. Nat. \_\_\_\_\_

1st 24 hrs. after shot \_\_\_\_\_


Gas \_\_\_\_\_ cu. ft.

Dry Hole \_\_\_\_\_

Abandoned \_\_\_\_\_

Map No. KANSAS Sec. 22 Twp. 16 R. 10<sup>th</sup>  
Well No. 1-Holtzburg Farm  
Beardmore Oil Company

990 Ft. from N. Line  
         Ft. from S. Line  
330 Ft. from E. Line  
         Ft. from W. Line

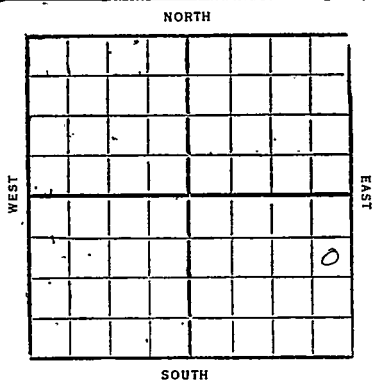

1932

| Date | REPORT             |
|------|--------------------|
| 2/3  | Reg                |
| 2/10 | Bedg rug           |
| 2/17 | Reg                |
| 2/26 | —                  |
| 3/2  | —                  |
| 3/9  | —                  |
| 3/16 | —                  |
| 3/22 | —                  |
| 3/30 | Reg                |
| 4/6  | Reg up             |
| 4/13 | 15 1/2" - 470'     |
| 4/20 | Oil 15 1/2" - 830' |
| 4/27 | 15" - 625'         |
|      | Drill 1610'        |
| 5/4  | " 2220'            |
| 5/11 | " 2785'            |
| 5/18 | 8" - 3040'         |
|      | show oil 3095'     |
|      | TD 3180' Fishing   |
| 5/25 | Drill 3320'        |
|      | (over)             |

6/1- Top Siliceous lime 3395  
T.D. 3400  
400' sul water  
Drift & Abandon

KANSAS

Ellsworth

Map No. \_\_\_\_\_ Sec. 22 Twp. 16 R. 10

Well No. 55 1 Stokenberg

Beardmore et al Company

Contractor

## FIRST REPORTS

## SECTION PLAT

|  |  |  |  |
|--|--|--|--|
|  |  |  |  |
|  |  |  |  |
|  |  |  |  |
|  |  |  |  |

990 Ft. from N. Line

\_\_\_\_\_ Ft. from S. Line

330 Ft. from E. Line

\_\_\_\_\_ Ft. from W. Line

Location \_\_\_\_\_

Rig up \_\_\_\_\_

Drilling and Remarks:

## RECORD

Cased \_\_\_\_\_ in., \_\_\_\_\_ ft.

Sand \_\_\_\_\_

Gas \_\_\_\_\_

Oil \_\_\_\_\_

Total Depth \_\_\_\_\_

## PRODUCTION

1st 24 hrs. Nat. \_\_\_\_\_

1st 24 hrs. after shot \_\_\_\_\_

Gas \_\_\_\_\_ Cu. Ft.

Dry Hole \_\_\_\_\_

Abandoned \_\_\_\_\_

Date  
FEB

3 1932

CHAS. L. SHERWOOD

19

Scout

55 KANSAS

Map No. Sec. 22 Twp. 16 R. 10

Well No. 1 Stoktenberg

Beardmore Oil #1 Company

Contractor

## COMPLETED

## SECTION PLAT

990 Ft. from N. Line.

Ft. from S. Line

330 Ft. from E. Line

Ft. from W. Line

ABANDONED

|  |  |  |  |
|--|--|--|--|
|  |  |  |  |
|  |  |  |  |
|  |  |  |  |
|  |  |  |  |
|  |  |  |  |

Location

Rig up

Drilling and Remarks:

Top Siliceous

Lime 3395

TD 3400

400' Sulphur Water

## RECORD

Cased in, ft.

Sand

Gas

Oil

Total Depth 3400

## PRODUCTION

1st 24 hrs. Nat.

1st 24 hrs. after shot

Gas Cu. Ft.

Dry Hole

Abandoned

Date

JUN 1 1932

CHAS. L. SHERWOOD

192

Scout