


Cowley

Section 8 Township 32 Range 6-E

Well No. 1 - Powers

Company Wakefield et al

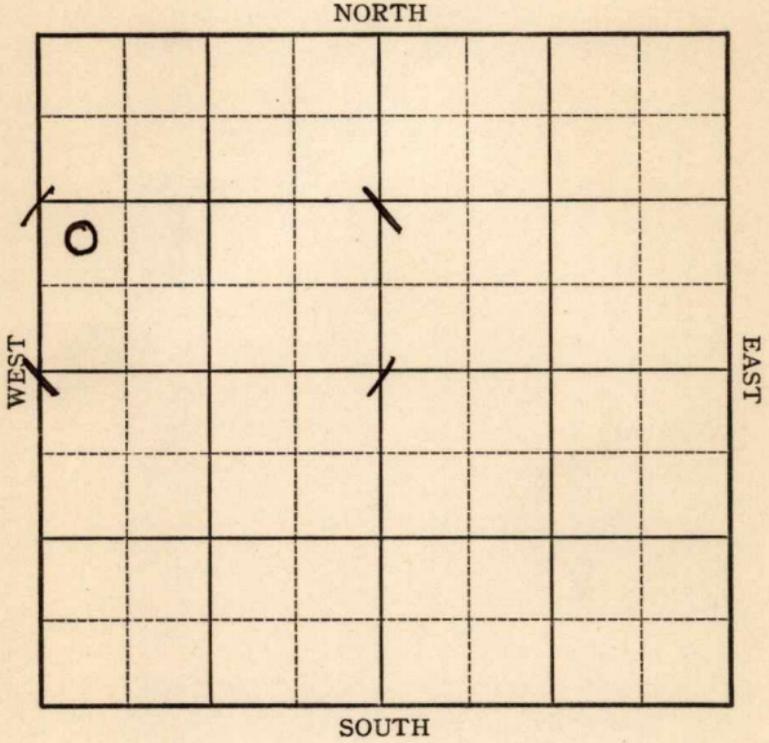

Sec. 8 Twp. 32 R. 6-E

Well No. #1 Powers Farm


Wakefield et al Company

\_\_\_\_\_ Ft. from N. Line

990 Ft. from S. Line

\_\_\_\_\_ Ft. from E. Line

330 Ft. from W. Line

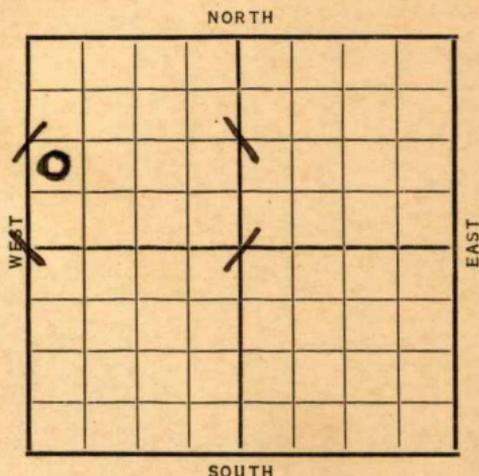

**Elev. 1361**

Date	REPORT
1937	
6/9	Cable rig.
6/19	" "
6/25	Drlg. 360'.
7/2	15" @ 505'. Drlg. 1012'.
7/9	10" @ 1725'. Drlg. 1735'.
7/16	8" @ 2035'. C.O.
7/23	Reaming 2600'.
7/28	<b>Miss 3157&amp;</b>
	TD 3160'
	D&A
	<b>ABANDONED</b>

Cowley **KANSAS**

Map No. \_\_\_\_\_ Sec. 8 Twp. 32 R. 6 <sup>E</sup>

Well No. 1-Powers

Wakefield etal Company  
Contractor

FIRST REPORT

SECTION PLAT


\_\_\_\_\_ Ft. from N. Line

990 Ft. from S. Line

\_\_\_\_\_ Ft. from E. Line

330 Ft. from W. Line

Map shows well drilled  
in SWNW but none was  
drilled

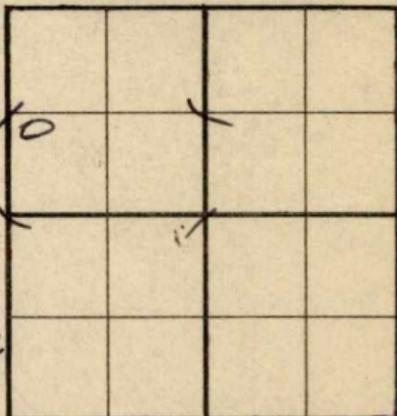

Location \_\_\_\_\_

Rig up \_\_\_\_\_

Drilling and Remarks:

Cable Rig

RECORD

Cased \_\_\_\_\_ in., \_\_\_\_\_ ft.

Sand \_\_\_\_\_

Gas \_\_\_\_\_

Oil \_\_\_\_\_

Total Depth \_\_\_\_\_

PRODUCTION

1st 24 hrs. Nat. \_\_\_\_\_

1st 24 hrs. after shot \_\_\_\_\_

Gas \_\_\_\_\_ Cu. Ft.

Dry Hole \_\_\_\_\_

Abandoned \_\_\_\_\_

Date

JUN 9 1937 19 H. D. Hatfield Scout

Cowley **KANSAS**

Map No. 2 Sec. 8 Twp. 32 R. 6E

Well No. 1 - Powers

Wakefield et al Company

Contractor

ABANDONED

SECTION PLAT

0			

\_\_\_\_\_ Ft. from N. Line

990 Ft. from S. Line

\_\_\_\_\_ Ft. from E. Line

330 Ft. from W. Line

Location \_\_\_\_\_

Rig up \_\_\_\_\_

Drilling and Remarks:

D & A

RECORD

Cased \_\_\_\_\_ in., \_\_\_\_\_ ft.

Sand MISS 3157

Gas \_\_\_\_\_

Oil \_\_\_\_\_

Total Depth 3160

PRODUCTION

1st 24 hrs. Nat. \_\_\_\_\_

1st 24 hrs. after shot \_\_\_\_\_

Gas \_\_\_\_\_ Cu. Ft.

Dry Hole \_\_\_\_\_

Abandoned \_\_\_\_\_

Date

JUL 28 1937 19

H. D. Hatfield Scout