


Ellsworth

Form 51-5M-2-29-34703

Map No. *KANSAS* Sec. *22* Typ. *16* R. *10^W*

Well No. *1-7 Stollenburg* Farm
Durby Oil & Allatam Company

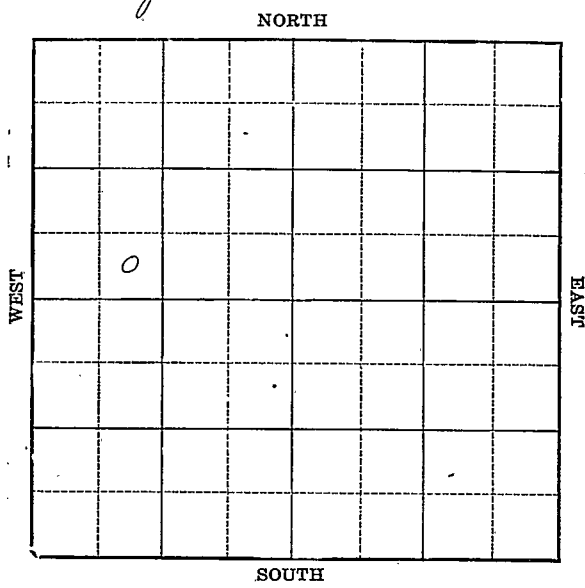

Location _____
Drilling Remarks _____

RECORD

Cased _____ in. _____ ft.
Sand _____
Gas _____
Oil _____
Total Depth _____

Rig Up _____
Drilling Remarks _____

PRODUCTION

1st 24 hrs. Nat. _____
1st 24 hrs. after shot _____
Gas _____ cu. ft. _____
Dry Hole _____
Abandoned _____

Map No. KANSAS Sec. 22 Twp. 16 R. 10^W
Well No. 1- Stattenberg Farm
Derby Oil & Aladdin Company


_____ Ft. from N. Line

330 Ft. from S. Line

_____ Ft. from E. Line

990 Ft. from W. Line

1931

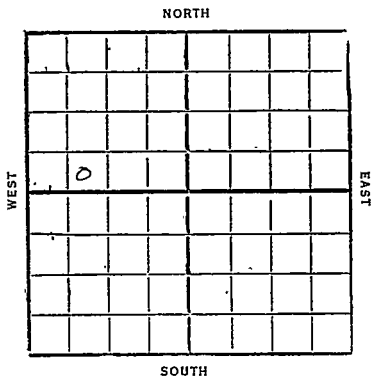

Date	REPORT
8/19	Log
8/26	ROS
9/2	—
9/9	—
9/16	—
9/23	—
9/30	—
10/7	—
10/14	Log
10/21	Run
10/28	227' Surface pipe SD 1640'
11/4	Dreg 2705'
11/10	" 3235'
11/18	Cored Cific line 3347-59 Good show Cem 8" 3347
11/23	At 3359 swabbed 75 bbls per hour — T.D. 3362' Tear- ing down rotary (Telephone) (over)

11/24 - Cored 3359-62
T.D. 3362
Swab 80 bbl 1 hr
Rust

12/2 —

12/9 —

12/16 —

12/22 —

12/30 - T.D. 3362' lime
400 full oil
Kill pump.

1932

1/6 - T.D. 3365' Silic lime
Pump 622 bbl 21 hr
" 1025 " 15 "

1/13 - Cased 8" 3347
Silic lime 3347-65
T.D. 3365
Pump 1525 bbl 24 hr
Comp.

Ellsworth


KANSAS

Map No. _____ Sec. 22 Twp. 16 R. 10 ^WWell No. 55 1 StarkenbergDerby Oil & Aladdin Company_____
Contractor

FIRST REPORTS

Ft. from N. Line330 Ft. from S. Line_____
Ft. from E. Line990 Ft. from W. Line

SECTION PLAT

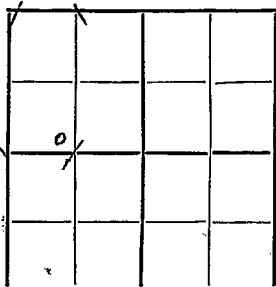Location ✓

Rig up _____

Drilling and Remarks:

RECORD

Cased _____ in., _____ ft.

Sand _____

Gas _____

Oil _____

Total Depth _____

PRODUCTION

1st 24 hrs. Nat. _____

1st 24 hrs. after shot _____

Gas _____ Cu. Ft.

Dry Hole _____

Abandoned _____

Date

AUG 19 1931

CHAS. L. SHERWOOD
Scout

Ellsworth


W

Map No. KANSAS Sec. 22 Twp. 16 R. 10Well No. 1 StoltenbergDerby Oil & Gas Co. Company

Contractor

COMPLETE

SECTION PLAT

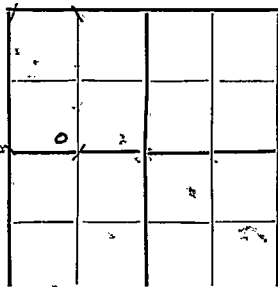

Ft. from N. Line

330 Ft. from S. Line

Ft. from E. Line

990 Ft. from W. Line

Location

Rig up

Drilling and Remarks:

Pump 1575 Bbl
24 Hours.

Cem RECORD

Cased 8 in. 3347 ft.Sand Sili 3347-3365

Gas

Oil

Total Depth 3365

PRODUCTION

1st 24 hrs. Nat.

1st 24 hrs. after shot

Gas Cu. Ft.

Dry Hole

Abandoned

Date

JAN 1 1932

CHAS. L. SHERWOOD

192

Scout