


Map No. 22 Sec. 16 Twp. 10<sup>W</sup>

Well No. 2 Hollenberg Farm

Gypsy & Palmer Company

NORTH

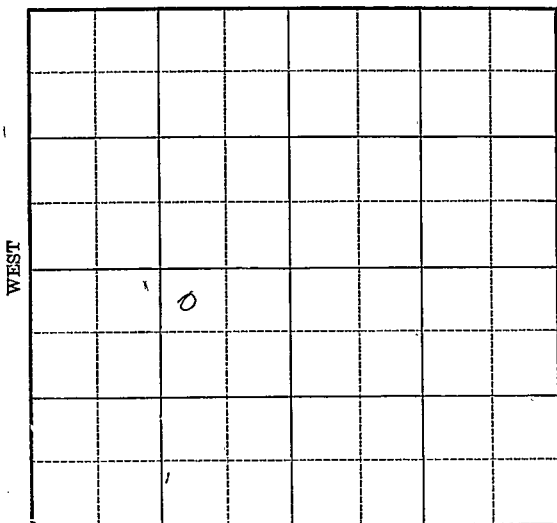

SOUTH

Location \_\_\_\_\_

Drilling Remarks \_\_\_\_\_

Rig Up \_\_\_\_\_

Drilling Remarks \_\_\_\_\_

RECORD

Cased \_\_\_\_\_ in. \_\_\_\_\_ ft.

Sand \_\_\_\_\_

Gas \_\_\_\_\_

Oil \_\_\_\_\_

Total Depth \_\_\_\_\_

PRODUCTION

1st 24 hrs. Nat. \_\_\_\_\_

1st 24 hrs. after shot \_\_\_\_\_

Gas \_\_\_\_\_ cu. ft.

Dry Hole \_\_\_\_\_

Abandoned \_\_\_\_\_

Map No. **KANSAS** Sec. 22 Twp. 16 R. 10<sup>W</sup>  
Well No. 2 - Stollenburg Farm  


330 Ft. from N. Line

           Ft. from S. Line

990 Ft. from E. Line

           Ft. from W. Line

1932

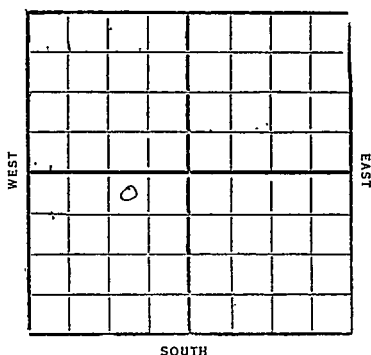

| Date | REPORT                           |
|------|----------------------------------|
| 3/2  | Bldg rig                         |
| 3/9  | Pos.                             |
| 3/16 | Bldg rig                         |
| 3/22 | Rig up                           |
| 3/30 | Spdg                             |
| 4/16 | " 20"-213                        |
| 4/13 | Drlg 465                         |
| 4/20 | " 12"-1016                       |
| 4/27 | Drlg 1365                        |
| 5/4  | " 10"-1950                       |
| 5/11 | Clg out                          |
| 5/18 | " 10"-2203                       |
| 5/25 | Drlg ahead                       |
|      | " 8"-2880'                       |
|      | Drlg 3305                        |
|      | " 6"-3338                        |
|      | Silic line 3337-58               |
|      | T.D. 3358                        |
|      | 1700' oil in hole                |
|      | swab 128 bbl 20 hr - 4 bbl water |
|      | Well shoot                       |

6/11- TD. 3358  
P.B. to 3354  
shot 80 qt 3342-54  
swab 5 bbls per hour  
for 8 hours  
Og out

6/18- (P.B. to 3354)  
shot 40 qt 3342-54  
swab 115 bbl 12 hrs

6/15- SD 3354

6/22- Cased 6"-3338  
Silic lime 3337-58  
TD 3358  
P.B. to 3354

shot 80 qt 3342-54  
" 40 " 3342-54  
swab 115 bbl 12 hrs  
Comp.

Ellsworth

55 KANSAS Map No. Sec. 22 Twp. 16 R. 10 W

Well No. 2 Stoltenberg

Gypsy &amp; Palmer Company

Contractor

## FIRST REPORTS


## SECTION PLAT

330 Ft. from N. Line

Ft. from S. Line

990 Ft. from E. Line

Ft. from W. Line

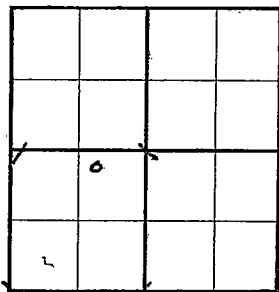

Location

## RECORD

Cased \_\_\_\_\_ in., \_\_\_\_\_ ft.

Sand \_\_\_\_\_

Gas \_\_\_\_\_

Oil \_\_\_\_\_

Total Depth \_\_\_\_\_

Rig up \_\_\_\_\_

Drilling and Remarks:

Bleg Rig

## PRODUCTION

1st 24 hrs. Nat. \_\_\_\_\_

1st 24 hrs. after shot \_\_\_\_\_

Gas \_\_\_\_\_ Cu. Ft.

Dry Hole \_\_\_\_\_

Abandoned \_\_\_\_\_

Date

MAR

2 1932

19

CHAS. L. SHERWOOD

Scout

Ellsworth

55

KANSAS

Map No. Sec. 22 Twp. 16 R. 10

Well No. 2 Stortenberg

Gypsy &amp; Palmer Company

Contractor

COMPLETED

SECTION PLAT

|  |    |  |  |
|--|----|--|--|
|  |    |  |  |
|  |    |  |  |
|  | 0. |  |  |
|  |    |  |  |

330 Ft. from N. Line

Ft. from S. Line

990 Ft. from E. Line

Ft. from W. Line

Location

Rig up

Drilling and Remarks:

Plug back to 335

Shot 80/3342-54

" 40/ "

Swab 115 Bls

in 12 hours

RECORD

Cased 6 in. 3338 ft.

Sand 3337-58

Gas

Oil

Total Depth 3358

PRODUCTION

1st 24 hrs. Nat.

1st 24 hrs. after shot

Gas Cu. Ft.

Dry Hole

Abandoned

Date

JUN 22 1932

CHAS. L. SHERWOOD

192

Scout