

Ellsworth

Form 252-A
5M 4-32 MPC

KANSAS

Map No. _____ Sec. 22 Twp. 16 R. 10W

Well No. 2-A Stoltenberg Farm


Derby Company

330 Ft. from N. Line

_____ Ft. from S. Line

_____ Ft. from E. Line

330 Ft. from W. Line

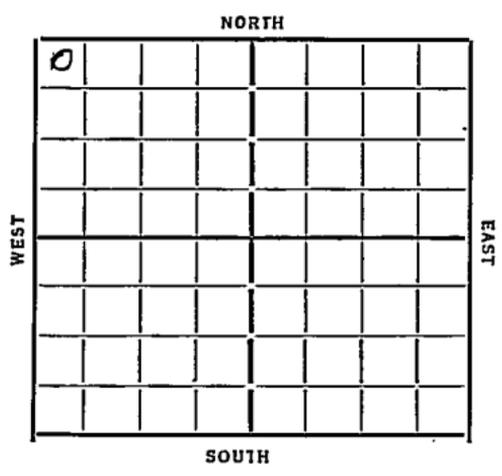

Date
1933

REPORT

7/26 Rgn up

8/2 12"-215' dily 975

8/9 dily 2590

8/16 " 3177'

8/23 6"-3340 dily 3348'

8/30 Siliceous 335 3/2 T.D. 3364 3100' oil swab
38 1/2 lbs per hr

9/6 no test yet

9/13 _____

9/20 Top Siliceous 3358 1/2
T. D. 3368 1/2
1700 lbs oil 70 lbs
water 24 hours

COMPLETED

Form 26-1M-BL-1826
Elsworth

Map No. 55 Sec. 22 Twp. 16 R. 10W

Well No. 27 Stollenberg

Derby Company

Contractor

SECTION PLAT

330 Ft. from N. Line

..... Ft. from S. Line

..... Ft. from E. Line

330 Ft. from W. Line

0			

FIRST REPORTS

Location.....

Rig up.....

Drilling and Remarks:

Ran up

RECORD

Cased.....in.,ft.

Sand.....

Gas.....

Oil.....

Total Depth.....

PRODUCTION

1st 24 hrs. Nat.....

1st 24 hrs. after shot.....

Gas.....Cu. Ft

Dry Hole.....

Abandoned.....

Date

7/26/33 192 Oval Mansfield Sc

Edsworth
 Map No. _____ Sec. *22* Twp. *16* R. *10W*
 Well No. *55-2-H Stollenberg*
Derby Company
 Contractor
rw cov

SECTION PLAT

330 Ft. from N. Line
 _____ Ft. from S. Line
 _____ Ft. from E. Line
330 Ft. from W. Line

0			

COMPLETED

Location _____
 Rig up _____
 Drilling and Remarks:

top siliceous
3358 1/2

1700 oil 70W
24 hrs

RECORD

Cased _____ in., _____ ft.
 Sand _____
 Gas _____
 Oil _____
 Total Depth *3368 1/2*

PRODUCTION

1st 24 hrs. Nat. _____
 1st 24 hrs. after shot _____
 Gas _____ Cu. Ft.
 Dry Hole _____
 Abandoned _____

Date

9/20/33 192 *O. Mannick*