


Ellsworth

Form 51-5M-5-34-Palace

Map No. KANSAS Sec. 22 Twp. 16 R. 10^W

Well No. 3 Stollenburg "A" Farm
Derby Oil Company

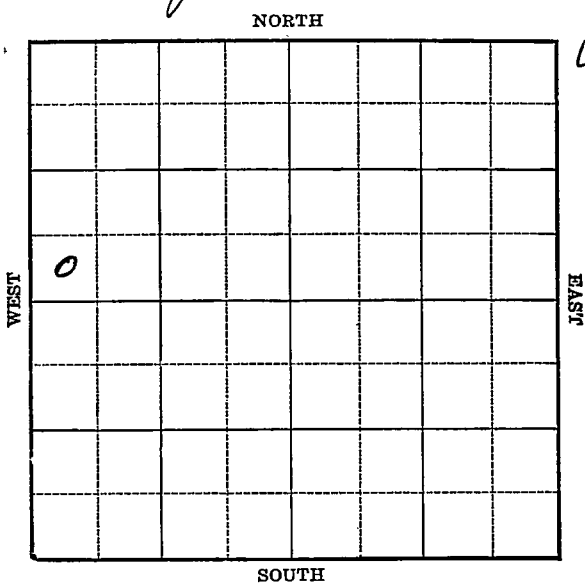

Location _____
Drilling Remarks _____

Rig Up _____
Drilling Remarks _____

RECORD

Cased _____ in. _____ ft.
Sand _____
Gas _____
Oil _____
Total Depth _____

PRODUCTION

1st 24 hrs. Nat. _____
1st 24 hrs. after shot _____
Gas _____ cu. ft. _____
Dry Hole _____
Abandoned _____

Ellsworth

Form 252-A
5M 4-32 MPC

Map No. KANSAS Sec. 22 Twp. 16 R. 10^W


Well No. 3 Stoltzberg "A" Farm
Derby Oil Company

 Ft. from N. Line

330 Ft. from S. Line

 Ft. from E. Line

330 Ft. from W. Line

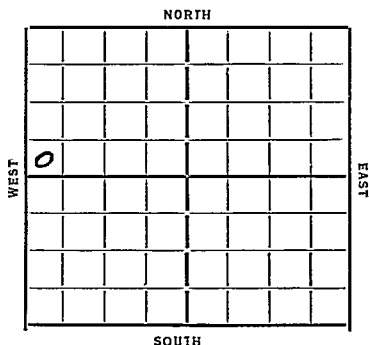

Date 1934

REPORT

6/30 Cellar
6/28 dog 234
7/5 " 1870
7/12 " 2900
7/19 G. Oil 3354 1/2 Cum 7"
7/26 TD 3357 2800' oil 4 1/2 hrs.
Revol 22 Bbls per hr.
8/2 Pump 937 Bbls 24 hrs.
1000 acid
8/8 Siliceous 3354 1/2 TD 3357
1000 acid 1754 oil 35 water

KANSAS

Map No. 55 Sec. 22 Twp. 16 R. 10 WWell No. 3-Stoltenberg 'A'Derby Oil Company

Contractor

FIRST REPORT SECTION PLAT

330 Ft. from N. Line330 Ft. from S. Line330 Ft. from E. Line330 Ft. from W. Line

0			

Location _____

Rig up _____

Drilling and Remarks:

cellar

RECORD

Cased _____ in., _____ ft.

Sand _____

Gas _____

Oil _____

Total Depth _____

PRODUCTION

1st 24 hrs. Nat. _____

1st 24 hrs. after shot _____

Gas _____ Cu. Ft.

Dry Hole _____

Abandoned _____

Date

6-20-34 19ORVAL MANNSCHRECK
Scout

Map No. 55 Sec. 22 Twp. 16 R. 10WWell No. 3- Stoltenberg 'H'Herby Oil Company

Contractor

COMPLETED

SECTION PLAT

0			

 Ft. from N. Line330 Ft. from S. Line Ft. from E. Line330 Ft. from W. LineLocation Rig up

Drilling and Remarks:

1000 acid1754 oil
35 water

RECORD

Cased in., ft.Sand silicious 3354 1/2Gas Oil Total Depth 3357

PRODUCTION

1st 24 hrs. Nat. 1st 24 hrs. after shot Gas Cu. Ft.Dry Hole Abandoned

Date

8-8-37

19

ORVAL MANNSCHRECK
Scout