

Ellsworth

Form 252-A
5M 4-32 MPC

KANSAS

Map No. _____ Sec. 22 Twp. 16 R. 10^w

Well No. 4 Staltemberg Farm


Gypsy + Stanolind Company

330 Ft. from N. Line

_____ Ft. from S. Line

_____ Ft. from E. Line

990 Ft. from W. Line

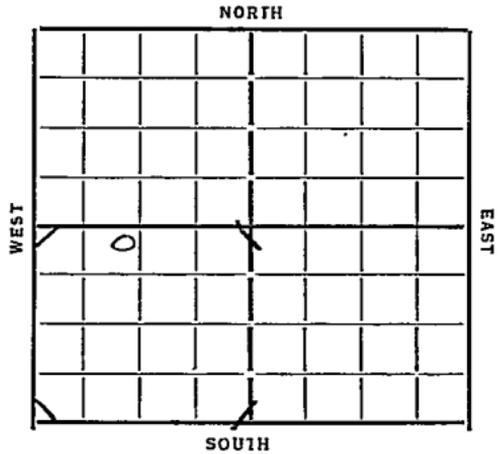

Date	REPORT
1933	
3/15	R. O. G.
3/15	Rigging up
3/29	20" 230' hOdy 450'
4/4	15" 470 12" 958 ddy 1350'
4/12	10" 2000' ddy 2150
4/19	ddy 2825'
4/26	8" 3190 ddy 3230
5/4	6" 3343 Seilover 3343-56 swab 401 bbls 7 hrs
5/10	swab 76 bbls per hr for 6 hrs
5/17	—
5/24	—
6/1	—
6/8	—
6/15	—
6/21	—
6/28	pumped 900 bbls 12 hrs well acidize T.D. 3356'
7/5	Top Seilover 3343' - 1000 gal acid 1910 bbls oil T.D. 3356'
	Completed

COMPLETED

Ellsworth

55 KANSAS

Map No. Sec. 22 Twp. 16 R. 10 W

Well No. 4 Stoltenberg

Gypsy & Standline Company

Contractor

FIRST REPORTS

SECTION PLAT

330 Ft. from N. Line

Ft. from S. Line

Ft. from E. Line

990 Ft. from W. Line

Location

Rig up

Drilling and Remarks:

P.O.S.

RECORD

Cased in, ft.

Sand

Gas

Oil

Total Depth

PRODUCTION

1st 24 hrs. Nat.

1st 24 hrs. after shot

Gas Cu. Ft.

Dry Hole

Abandoned

Date

MAR 15 1933

CHAS. L. SHERWOOD Scout

Map No. 55 Sec. 22 Twp. 16 R. 10W.

Well No. 4 Stoltzenberg

Gypsy & Shand Company

Contractor

SECTION PLAT


330 Ft. from N. Line

..... Ft. from S. Line

..... Ft. from E. Line

990 Ft. from W. Line

COMPLETED

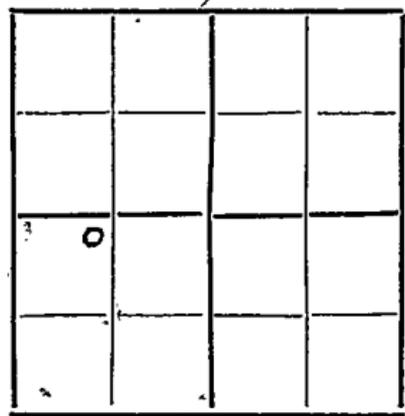

Location.....

Rig up.....

Drilling and Remarks:

Top siliceous
334'3
1000 gal acid
1910 bbls oil

RECORD

Cased..... in., ft.

Sand.....

Gas.....

Oil.....

Total Depth 3356

PRODUCTION

1st 24 hrs. Nat.....

1st 24 hrs. after shot.....

Gas..... Cu. Ft.

Dry Hole.....

Abandoned.....

Date

7/5/33 192 Orval M. Marchese