

KANSAS


Ellsworth

Form 51-5M 5-37 Petrol

Section 23 Township 16- Range 10-W

Well No. #1 Stratman

Company Marylyn Oil

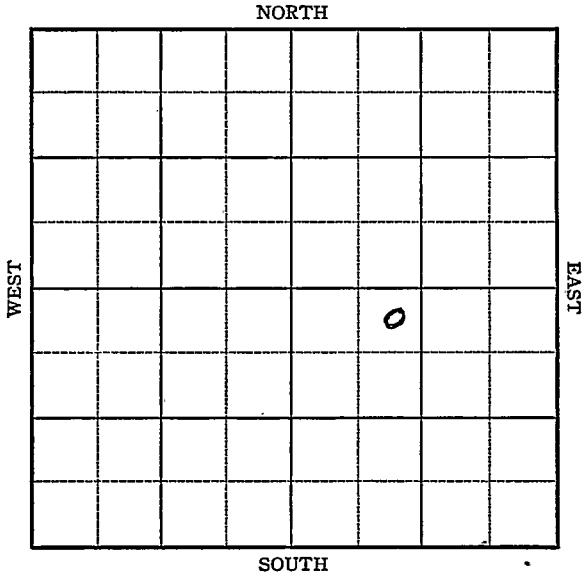


KANSAS

Ellsworth

Sec. 23 Twp. 16 R. 10-WWell No. #1 Stratman FarmMarylyn Oil Company330 Ft. from N. Line Ft. from S. Line Ft. from E. Line990 Ft. from W. Line

Elev. 1891

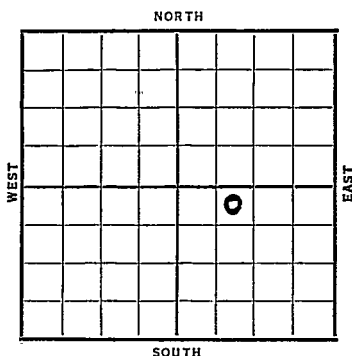

Date	REPORT
1937	
10/27	B.C.R.
11/5	Spud.
11/12	"
11/19	"
11/26	"
12/3	15" @ 404'. 12" @ 635'.
	Drlg. 640'.
12/10	Drlg. 1000'.
12/17	10" @ 1716'.
	Drlg. 1916'.
12/24	Drlg. 2185'.
12/31	Drlg. 2685'.
1938	
1/7	Fsg. 3000'.
1/14	4 B.W. 2905-3005'.
	Lans. 3033'. Fsg. 3045'.
	No shows.
1/20	" " " "
1/28	S.O. 3165-70 Drlg. 3170'.
	OVER

1938

2/4 Lans. 3019' (Corrected)

S.G. 3093-95 6" - 3235'

H.F.W. 3265-70 U.R. 6" 3280'

2/9 6" @ 3280'.

Cong. 3372'.

Arb. 3455'.

Water 3457-61'.

T.D. 3461'.

ABANDONED

Map No. 55 Sec. 23 Twp. 16 R. 10WWell No. 1 StratmanMarylyn Oil Company

Contractor

FIRST REPORT

NE NW SE

330 Ft. from N. Line Ft. from S. Line Ft. from E. Line990 Ft. from W. Line

SECTION PLAT

		0	

Location Rig up

Drilling and Remarks:

BCR

RECORD

Cased in., ft.Sand Gas Oil Total Depth

PRODUCTION

1st 24 hrs. Nat. 1st 24 hrs. after shot Gas Cu. Ft.Dry Hole Abandoned

Date

OCT 27 1937

19

H. D. Hatfield Scout

Map No. 55 Sec. 23 Twp. 16 R. 10WWell No. 1 StratmanMarylyn Oil Company

Contractor

ABANDONED

NE NW SE

330 Ft. from N. Line

_____ Ft. from S. Line

_____ Ft. from E. Line

990 Ft. from W. Line

SECTION PLAT

		0	

Location _____

Rig up _____

Drilling and Remarks:

Cong 3372
arb. 3455
water 3457-61

DVA

RECORD

Cased 6 in., 3280 ft.

Sand _____

Gas _____

Oil _____

Total Depth 3461

PRODUCTION

1st 24 hrs. Nat. _____

1st 24 hrs. after shot _____

Gas _____ Cu. Ft.

Dry Hole _____

Abandoned _____

Date

FEB 9 1938 19 H. D. Hatfield Scout