

FORM 51


Cowley

KANSAS

Section 12 Township 32 Range 6E

Well No. 1 Perick

Company Crest Petroleum

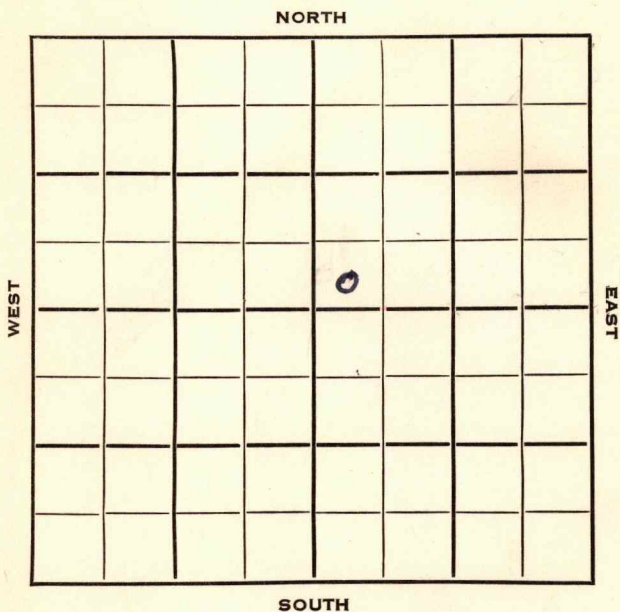

Cowley

KANSAS

Sec. 12 Twp. 32 R. 6 E

Well No. # 1 Rerick Farm

Crest Petroleum Company

Contractor


Ft. from N. Line

330 Ft. from S. Line

Ft. from E. Line

330 Ft. from W. Line

SW SW NE

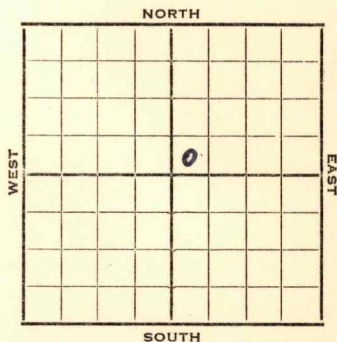

1952

Elev. 1384'

REPORT

11/26

Location

4/22

D & A

TD 2215'

Layton 2190

TD 2215

5" @ 2215'

32/ 2190-98 4 bo 12 bwpd

D & A

ABANDONED

$$\begin{array}{r}
 2190 \\
 1384 \\
 \hline
 -806
 \end{array}$$

