



Cowley

Map No. **KANSAS** Sec. 12 Twp. 32 R. 6<sup>E</sup>

Well No. 3 - Estes Farm

Trues Oil Company


660 Ft. from N. Line

Ft. from S. Line

660 Ft. from E. Line

Ft. from W. Line

1930

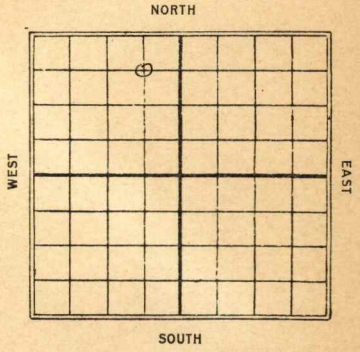

Date

REPORT

Date	REPORT
6/18	Drily 350'
6/25	" 905'
7/2	8" - 1510 Drily. 1585'
7/9	Drily. 1950'
	6" - 1914'
7/16	Drily. 2140'
7/23	Sample 2187 - 97'
	Shot 20 qts 700'
	oil - Drily. 2200'
7/30	Drily. 2420'
8/6	SD. 2456'
8/13	Gas 2471 - 93
	TD 2494
	1 1/2 M gas
	Comp.

2187  
 1386  
 801

Cowley

Map No. **KANSAS** Sec. 12 Twp. 32 R. 6

2 Well No. 3 Estes

Innes Oil Co Company

Contractor

**COMPLETE**

**SECTION PLAT**

	0		

660 Ft. from N. Line

\_\_\_\_\_ Ft. from S. Line

660 Ft. from E. Line

\_\_\_\_\_ Ft. from W. Line

Location \_\_\_\_\_

Rig up \_\_\_\_\_

Drilling and Remarks:

**RECORD**

Cased \_\_\_\_\_ in., \_\_\_\_\_ ft.

Sand 2471-2493

Gas \_\_\_\_\_

Oil \_\_\_\_\_

Total Depth 2494

**PRODUCTION**

1st 24 hrs. Nat. \_\_\_\_\_

1st 24 hrs. after shot \_\_\_\_\_

Gas 1 1/2 M Cu. Ft.

Dry Hole \_\_\_\_\_

Abandoned \_\_\_\_\_

Date

AUG 13 1930

19

**CHAS. L. SHERWOOD**

Scout

2  
Map No. **KANSAS** Sec. 12 Twp. 32 R. 6E

Well No. 3 Estes

Trees Oil Company

Contractor

**FIRST REPORTS**

660 Ft. from N. Line

\_\_\_\_\_ Ft. from S. Line

660 Ft. from E. Line

\_\_\_\_\_ Ft. from W. Line

**SECTION PLAT**

	0		

Location \_\_\_\_\_

Rig up \_\_\_\_\_

Drilling and Remarks:

Dry 350'

**RECORD**

Cased \_\_\_\_\_ in., \_\_\_\_\_ ft.

Sand \_\_\_\_\_

Gas \_\_\_\_\_

Oil \_\_\_\_\_

Total Depth \_\_\_\_\_

**PRODUCTION**

1st 24 hrs. Nat. \_\_\_\_\_

1st 24 hrs. after shot \_\_\_\_\_

Gas \_\_\_\_\_ Cu. Ft.

Dry Hole \_\_\_\_\_

Abandoned \_\_\_\_\_

Date

**JUN 18 1930**

**CHAS. L. SHERWOOD**

Scout