

**KANSAS**


Ellsworth

Section 22 Township 16 Range 10-W

Well No. #1 Julia Stoltenberg "B"

Company Stanolind & Gulf

NORTH Stoltenberg Pool

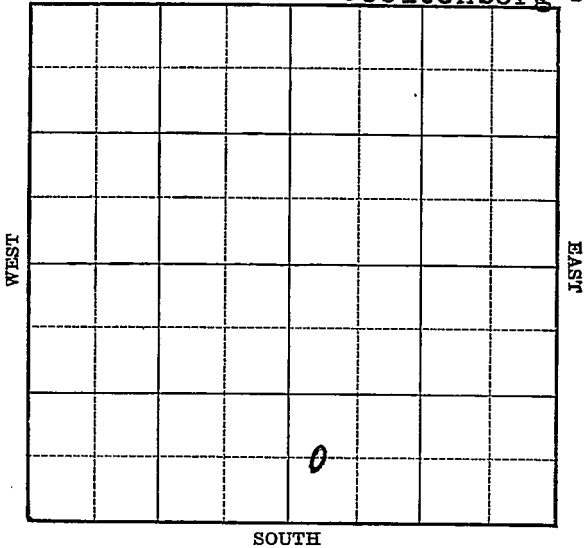

15

0



1940  
7/10

Arb. 3301'

5" - 3300'

T.D. 3308'

1000 acid.

Depthograph potential 14,613

Maximum allowed 3000 bbls.

COMPLETED

Map No. 55 Sec. 22 Twp. 16 R. 10WWell No. 1 Julia Stoltenberg "B"Stanolind & Gulf Company

Contractor

## FIRST REPORT

C W L SW SE

         Ft. from N. Line660 Ft. from S. Line         Ft. from E. Line330 Ft. from W. Line

STOLTENBERG POOL

## SECTION PLAT

		o	

Location XRig up         

Drilling and Remarks:

## RECORD

Cased          in.,          ft.Sand         Gas         Oil         Total Depth         

## PRODUCTION

1st 24 hrs. Nat.         1st 24 hrs. after shot         Gas          Cu. Ft.Dry Hole         Abandoned         

Date

APR 10 1940 19

S. J. LEWIS Scout

Map No. \_\_\_\_\_ Sec. 22 Twp. 16 R. 10W

Well No. 1 Julia Stoltenberg "B"

Stanolind \_\_\_\_\_ Company

\_\_\_\_\_  
Contractor

**COMPLETED**

C W L SW SE

\_\_\_\_\_ Ft. from N. Line

660 Ft. from S. Line

\_\_\_\_\_ Ft. from E. Line

330 Ft. from W. Line

**SECTION PLAT**


**STOLTENBERG POOL**

Location \_\_\_\_\_

Rig up \_\_\_\_\_

Drilling and Remarks:

*See 3301*  
*5" @ 3300*  
*10000 cu ft*  
*Depth to top of hole*  
*14613*  
*May 3000*

**RECORD**

Cased \_\_\_\_\_ in., \_\_\_\_\_ ft.

Sand \_\_\_\_\_

Gas \_\_\_\_\_

Oil \_\_\_\_\_

Total Depth 2308

**PRODUCTION**

1st 24 hrs. Nat. \_\_\_\_\_

1st 24 hrs. after shot \_\_\_\_\_

Gas \_\_\_\_\_ Cu. Ft.

Dry Hole \_\_\_\_\_

Abandoned \_\_\_\_\_

Date

JUL 10 1940 19

S. J. LEWIS Scout