

Map No. 12 Sec. 32 Twp. 6

Well No. 1-Mansur Farm

Trues Oil Co Company

NORTH

WEST

EAST

				0			

1332 SOUTH

Location.....

Drilling Remarks

.....

.....

RECORD

Cased.....in.....ft.

Sand.....

Gas.....

Oil.....

Total Depth.....

Rig Up.....

Drilling Remarks

.....

.....

PRODUCTION

1st 24 hrs. Nat.....

1st 24 hrs. after shot.....

Gas.....cu. ft.....

Dry Hole.....

Abandoned.....

Map No. **KANSAS** Sec. 12 Twp. 32 R. 6

Well No. 1-Mansel Farm


990 Ft. from N. Line

Ft. from S. Line

Ft. from E. Line

330 Ft. from W. Line

1929

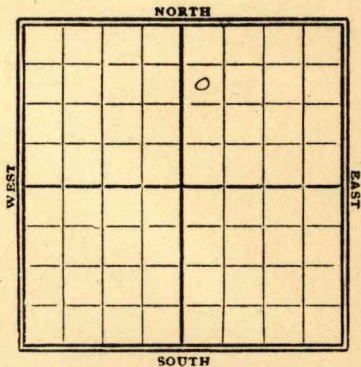

Date _____

REPORT

1/23 Rig
1/30
2/16 Rig up
2/13
2/20
2/27 Drilg 505'
3/6 " 1100'
3/13 " 1400'
3/20 " 1860'
3/27 " 2050'
4/3 " 2360'
4/10 sand 2428-51'
TD. 2451'
1 1/4 M gas
Comp. as gas well

Map No. **KANSAS** Sec. *12* Twp. *32* R. *6*

Well No. *1* *Mansey*
Drill Oil Co Company

Contractor

COMPLETE

SECTION PLAT

		o	

990 Ft. from N. Line

..... Ft. from S. Line

..... Ft. from E. Line

330 Ft. from W. Line

Location.....

Rig up.....

Drilling and Remarks:

gas well.

RECORD

Cased.....in.,.....ft.

Sand *7428-7451*

Gas.....

Oil.....

Total Depth *7451*

PRODUCTION

1st 24 hrs. Nat.....

1st 24 hrs. after shot.....

Gas *1 1/4 M* Cu. Ft.

Dry Hole.....

Abandoned.....

Date

APR 10 1929

CHAS. L. SHERWOOD

192.....

Scout

Cowley
 Map No. **KANSAS** Sec. *12* Twp. *32* R. *6*

Well No. *1* *Manser*
Deer Oil Co Company

Contractor

FIRST REPORTS

990 Ft. from N. Line

..... Ft. from S. Line

..... Ft. from E. Line

330 Ft. from W. Line

SECTION PLAT

		o	

Location.....

Rig up ☒

Drilling and Remarks:

RECORD

Cased.....in.,ft.

Sand.....

Gas.....

Oil.....

Total Depth.....

PRODUCTION

1st 24 hrs. Nat.....

1st 24 hrs. after shot.....

Gas.....Cu. Ft.

Dry Hole.....

Abandoned.....

Date

JAN 23 1929

CHAS. L. SHERWOOD

192.....

Scout