

Map No. KANSAS Sec. 23 Twp. 16 R. 10^W

Well No. 1-Stratman Farm
Williams & Moore Company


NORTH

_____ Ft. from N. Line

660 Ft. from S. Line

_____ Ft. from E. Line

660 Ft. from W. Line

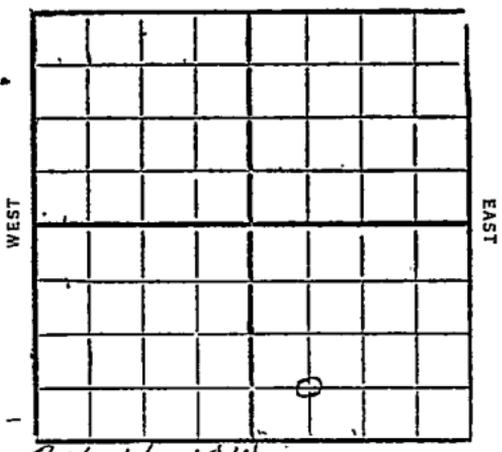

1931 ^{Our lease -} N 1/2 - 1/4 E 1/4 sec 34-16-10^W

Date	REPORT
9/30	LOG.
10/7	Build rig
10/14	Rig up
10/21	Drill 75'
10/28	Drill 510'
11/4	" 12" - 625'
	Drill 1070'
11/10	5 barrel water 1710'
	Drill 1725'
11/18	" 1950'
11/24	10" - 2010'
	Drill 2150'
12/2	" " 2300'
12/9	" " 2345'
12/16	10" 2344'
	Drill 2655'
12/22	1/2 M gas 3028'
	show oil & gas 3035'
	Est 8 to 10 M gas
	from 3095-98'
12/30	4 1/2 M gas 3095-98'
	8" 3125' Drill 3130'

1932

1/6- 1 bauler water from
3195-3204
Top Cong 3318
SD. 3327

1/13- Top Siliceous lime 3388. set 6"
Pay 3390-91. Filled up
3100 feet oil in 30 minutes.
Preparing to test -
(Telegram)

1/20 - TD. 3391
Cem 6" csg
Still run tubing & rods

1/27 —
2/3- TD. 3391 No test
Re-cem 6" csg

2/10- SD. 3391 TD.
2/17- TD. 3391 Run 5"
to mill out cement

2/26 —

3/2 —

3/9 —

3/16- SD 3391

3/22 —

3/30 —

4/6 —

4/13- TD. 3391

Isq 2 joints tubing

4/20 —

4/27- TD. 3391 Cemented
shut down

Map No. Kansas Sec. 23 Twp. 16 R. 10^w

Well No. 1-Stratman Farm
Williams & Moore Company


_____ Ft. from N. Line

660 Ft. from S. Line

_____ Ft. from E. Line

660 Ft. from W. Line

1932

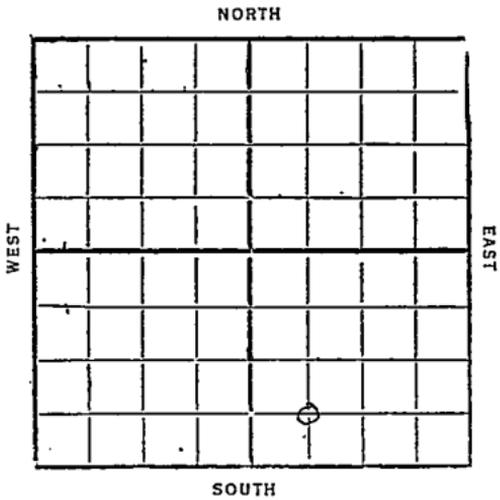

Date

REPORT

5/14	Top of Oil 3388
	Pay 3390-92
	3" - 3392
	TD 3392
	Pump 30 bbl 1st hour
	" 23 3/4 " 2nd "
	" 22 1/2 " 3rd "
	" 29 " 4th "
	" 30 " 5th "
	34° gravity at 85°
	show 10% 13.5 & 20% water
	Averaged 35 bbl per
	hour for next 5 hrs
	30% water
5/11	TD 3392
	Pump 35 bbl per hour
	for 48 hours
	30% water
5/18	SD 3392 TD
5/25	—
6/1	—
6/8	—

6/15- TD. 3392

Pump 210 bbl June 10

" 252 " " 11

" 435 " " 12

with 30 bbl water per hr

6/22- Silic lime 3388-92' 3"

TD. 3392' 3"

Pump 350 bbls oil
and 350 bbl water
in 24 hr

Comp.

55

Form 26—1M Bks.—9-26

Ellsworth

Map No. KANSAS Sec. 23 Twp. 16 R. 10^W

Well No. 1 Stratman

Williams & Moore Company

Contractor

FIRST REPORTS

SECTION PLAT

.....Ft. from N. Line

660 Ft. from S. Line

.....Ft. from E. Line

660 Ft. from W. Line

	1		
		0	

Our lease
N^W NE⁴ of Sec. 34

Location.....

Rig up..... Roy

Drilling and Remarks:

RECORD

Cased..... in., ft.

Sand.....

Gas.....

Oil.....

Total Depth.....

PRODUCTION

1st 24 hrs. Nat.....

1st 24 hrs. after shot.....

Gas..... Cu. Ft.

Dry Hole.....

Abandoned.....

Date

SEP 30 1931₁₉₂ CHAS. L. SHERWOOD

Scout

Ollsworth

55 KANSAS

Map No.

Sec. 23

Twp. 16

R. 10 W

Well No. 1

Stratman

Williams & Moore

Company

Contractor

COMPLETED

SECTION PLAT

..... Ft. from N. Line

660 Ft. from S. Line

..... Ft. from E. Line

660 Ft. from W. Line

Location.....

RECORD

Rig up.....

Drilling and Remarks:

Cased..... in..... ft.

Sand *siliceous* 3388-92-3"

Gas.....

Oil.....

Total Depth 3392-3"

*Pump 350 Bbs Oil
350 Bbs Water
in 24 Hours.*

PRODUCTION

1st 24 hrs. Nat.....

1st 24 hrs. after shot.....

Gas..... Cu. Ft.

Dry Hole.....

Abandoned.....

Date

JUN 22 1932

CHAS. L. SHERWOOD

192.....

Scout