


Section 12 Township 32 Range 6E

Well No. #6 Rerick

Company Blair & Bedell & Catt

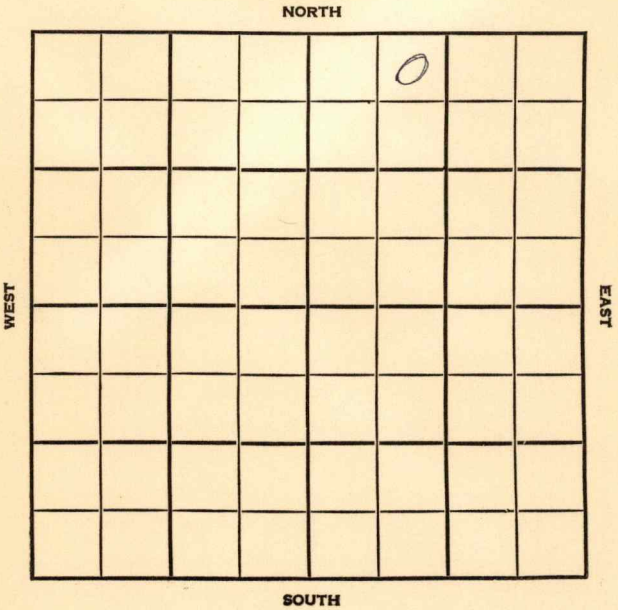

~~Cowley~~
County Cowley Elev. 1350 df
Sec. 12 Twp. 32 Rge. 6E
Company Blair & Bedell & Catt
Farm Name Rerick No. 6

TOPS	DEPTH	LOG	DATUM	Loc. in Sec.
Anh.				NE NW NE
Tp.				
H.				
Tr.				
Dg.				
BL.				
L.				
K.C.				Geol.
B.K.C.				Contr.
Ce.				<u>Bedell & Catt</u>
C.				<u>Tools Burden</u>
M.				<u>Pool</u>
M.				<u>ESTES</u>
K.				<u>Townsite</u>
Mz.				
Mq.				
V.				
S.				
S.				
A.				
R.				
Pf.				
G.				
T.D.				

Date Comm. spd. 10-19-56
8" @ 125, w/85, Drlg. 1635

Nov 5 1956
R. G.

County Cowley Elev. 1350 df
 Sec. 12 Twp. 32 Rgs. 6E
 Company Blair & Bedell & Catt
 Farm Name Rerick No. 6

TOPS	DEPTH	LOG	DATUM	Loc. in Sec.
Anh.				NE NW NE
Tr.				
H.				
Tr.				
Dg.				
BL. <u>Parted 2160</u>				
L. <u>Lgt. 2160</u>				
K.C.				
B.K.C.				
Ce.				
C.				
M.				
M.				
K.				
Mz.				
Mq.				
V.				
S.				
S.				
A.				
R.				
PE.				
G.				
T.D.	<u>2212</u>			

Geol. Surden
 Contr. Bedell & Catt
 Tools Popl
 ESTES

NOV 7 '56

ABANDONED

Date Comm. spd. 10-19-56

8" @ 125, w/85, Drlg. 1635 OCT 31 '56

9 1/2 @ 2211 CO 48/2164-70

fstg. NOV 7 '56 FRAC 1 X 1 comp
for SWD well