

KANSAS


Butler

Section 32 Township 25 Range 4E

Well No. 1 Edminston

Company E. Adair et al

NORTH **Misc.**

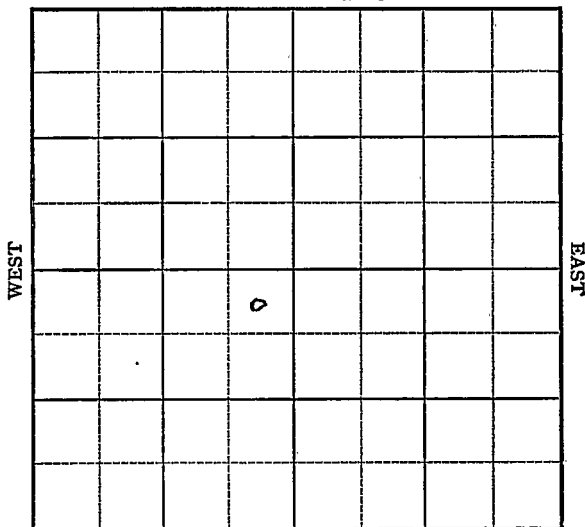

SOUTH

KANSAS


Butler

Sec. 32 Twp. 25 R. 4E ✓Well No. #1 Edminston FarmE. Adair et al Company

Miscellaneous

330' Ft. from N. Line Ft. from S. Line330' Ft. from E. Line Ft. from W. Line

NE SW

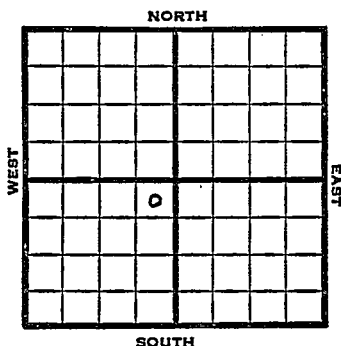1949 E lev 1302' REPORT

3/23 Location
3/30 Mach.
4/6 15" @ 75'
Drlg. 600'
4/12 Drlg. 1000'
4/20 10" @ 1670'
Lansing 1790'
KC 2075'
8" @ 2211'
Drlg. 2305'
4/27 Chat 2475'
Viola 2618'
TD 2620'
7" @ 2618'
5/4 TD 2627'
200' oil 1 hr
5/11 TD 2627'
Viola 2618'
7" @ 2618'
Pump 30 Oil Pot
38° Gr.
Comp

COMPLETED

Map No. _____ Sec. 32 Twp. 25 R. 4E

Well No. 1 Edminston

E. Adair et al. Company

FIRST REPORT

Contractor

NE SW


SECTION PLAT

330 Ft. from N. Line

_____ Ft. from S. Line

330 Ft. from E. Line

_____ Ft. from W. Line

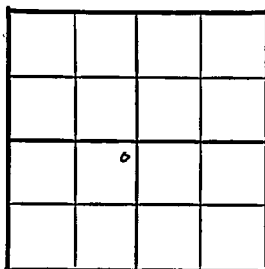

Butler County

Location X

Rig up _____

Drilling and Remarks:

RECORD

Cased _____ in., _____ ft.

Sand _____

Gas _____

Oil _____

Total Depth _____

PRODUCTION

1st 24 hrs. Nat. _____

1st 24 hrs. after shot _____

Gas _____ Cu. Ft.

Dry Hole _____

Abandoned _____

Date

MAR 23 1949 19

S. J. LEWIS

Scout

Map No. K 14 Sec. 32 Twp. 25 R. 4E

Well No. 1 Edminston

E. Adair et al. Company

COMPLETE

Contractor

NE SW

E 1/302

SECTION PLAT

330 Ft. from N. Line

_____ Ft. from S. Line

330 Ft. from E. Line

_____ Ft. from W. Line

Butler County

Location _____

Rig up _____

Drilling and Remarks:

Via to 2618.

7 C 2618.

Pump 80 oil Prod.

85-4

RECORD

Cased _____ in., _____ ft.

Sand _____

Gas _____

Oil _____

Total Depth 2627

PRODUCTION

1st 24 hrs. Nat. _____

1st 24 hrs. after shot _____

Gas _____ Cu. Ft.

Dry Hole _____

Abandoned _____

Date

MAY 11 1949

19

S. J. LEWIS

Scout