

KANSAS Butler

Section 32 Township 25 Range 4E

Well No. 2 McCullough

Company E. Adair et al

Misc.

NORTH

WEST

EAST

		0					

SOUTH

Sec. 32 Twp. 25 R. _____

Well No. #2 McCullough Farm _____

E. Adair et al Company _____

Miscellaneous


_____ Ft. from N. Line

330' Ft. from S. Line

990' Ft. from E. Line

_____ Ft. from W. Line

SW SE NW

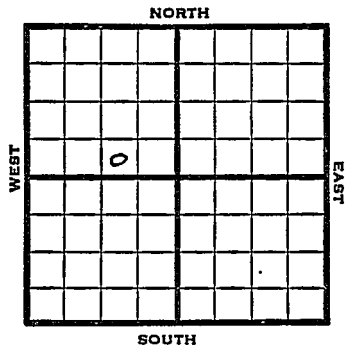

1949 Elev 1316' REPORT

7/6 Location
7/12 Spud
7/20 15" @ 165'
13" @ 851'
Drlg 1135'
7/27 10" @ 1707'
Drlg 2095'
8/3 KC 2090'
8" @ 2262'
Miss 2515'
Viola 2621'
TD 2625'
7" @ 2625'
800 oil 8 hrs.
8/10 TD 2629'
Viola 2313' ?
7" @ 2613
Pump 35 Oil Pot
38° Gr.
Comp

COMPLETED

Kansas

Map No. _____ Sec. 32 Twp. 25 R. 4EWell No. 2 McCulloughE. Adair et al. CompanyAdair Contractor

SW SE NW

FIRST REPORT
SECTION PLAT

_____ Ft. from N. Line

330 Ft. from S. Line990 Ft. from E. Line

_____ Ft. from W. Line

Butler County

Location X

Rig up _____

Drilling and Remarks:

RECORD

Cased _____ in., _____ ft.

Sand _____

Gas _____

Oil _____

Total Depth _____

PRODUCTION

1st 24 hrs. Nat. _____

1st 24 hrs. after shot _____

Gas _____ Cu Ft

Dry Hole _____

Abandoned _____

Date

JUL 6 1949 19S. J. LEWIS Scout

