FORM 51 25M 8-50 WESTERN


Butler

KANSAS

Section 31 Township 25 Range 4 E

Well No. #3 Randall

Company E. H. Adair

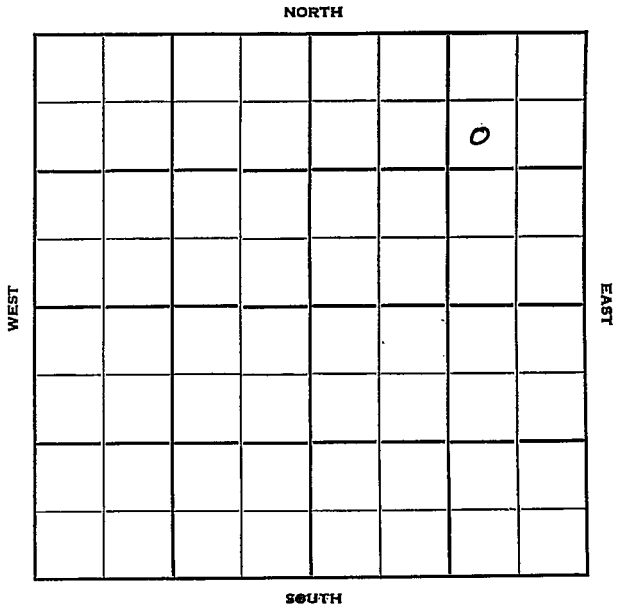

FORM 252-B
10M 11-50 PETROL

Butler KANSAS

Sec. 31 Twp. 25 R. 4E

Well No. #3 Randall Farm

E. H. Adair Company

~~White Water Pool~~ Contractor


990' Ft. from N. Line

Ft. from S. Line

990' Ft. from E. Line

Ft. from W. Line

SW NE NE

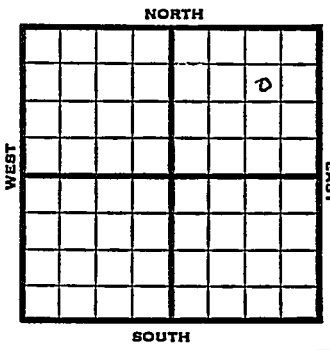

1951	Elev. 1290' REPORT
1/31	RUR
3/7	Oil well TD 2621' 15" @ 153 13" @ 900 10" @ 1782 KC 2085 8" @ 2243 Cong. 2505 Miss 2519 Viola 2618 7" @ 2618 TD 2621 Comp. 25 bopd **COMPLETED**

FORM 275 FOR SALE BY KANSAS BLUE PRINT CO.


County Butler State Kansas

Sec. 31 (Blk. Twp.) 25 (Sur. Rge.) 4E Map No.

Operator E. H. Adair

Well No. 3 Farm Randall

Elev. Location SW NE NE

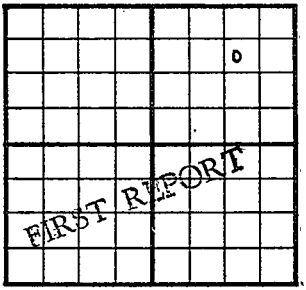

990 Ft. From N Line NE

990 Ft. From E Line Quarter

1st. Report JAN 31 1951

Completion

Remarks

Spudding Date

Drlg. Data White Water Pool

R U R

J. E. TYRA

FORM 275 FOR SALE BY KANSAS BLUE PRINT CO.


County Butler State Kansas

Sec. 31 (Blk. / Twp.) 25 (Sur. / Rge.) 4E Map No.

Operator E. H. Adair

Well No. 3 Farm Randall

Elev. 1290 Location SW NE NE

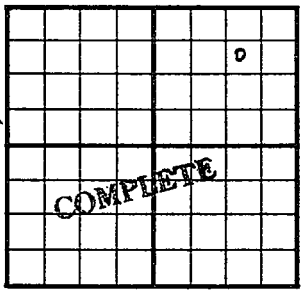

990 Ft. From N Line NE

990 Ft. From E Line Quarter

1st. Report

Completion MAR 7 1951

Remarks White Water Pool

Spudding Date

Drlg. Data Oil well TD 2621

15" @ 153 13" @ 900 10" @ 1782

KC 2085 8" @ 2243 Cong. 2505

Miss. 2519 Viola 2618 7" @ 2618

TD 2621 Comp. 25 bopd

J. E. TYRA