

KANSAS

Butler

Section 32 Township 25 Range 4E

Well No. 3 McCullough

Company E. Adair et al

Misc.

NORTH

		o					

WEST

EAST

SOUTH

Sec. 32 Twp. 25 R. 4E

Well No. #3 McCullough Farm

E. Adair et al Company

Miscellan- (E. Adair, Cont.)


 Ft. from N. Line

990' Ft. from S. Line

990' Ft. from E. Line

 Ft. from W. Line

NORTH

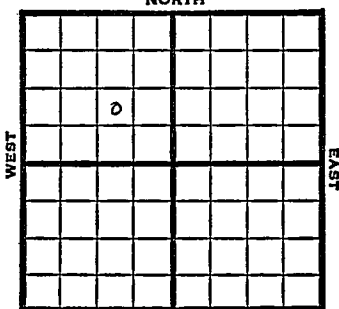

SOUTH

NW SE NW

1949 ^E lev 1343' REPORT

8/10 Location
8/16 15" @ 185'
Drlg. 410'
8/24 "
8/31 Lansing 1840'
KC 2120'
Drlg 2135'
9/7 Miss 2650'
TD 2651'
3" @ 2650'
9/14 TD 2668
200' oil 3½ hrs.
9/21 TD 2668'
Miss 2650'
7" @ 2650'
Pump 35 Oil Pot
38° Gr. (38° SW)
Comp

COMPLETED

Kansas

Map No. _____ Sec. 32 Twp. 25 R. 4EWell No. 3 McCulloughE. Adair et al.

Company

E. Adair

Contractor

NW SE NW

FIRST REPORT
SECTION PLAT

_____ Ft. from N. Line

990 Ft. from S. Line990 Ft. from E. Line

_____ Ft. from W. Line

	o	p	

Butler County

RECORD

Location X

Cased _____ in., _____ ft.

Rig up _____

Sand _____

Drilling and Remarks:

Gas _____

Oil _____

Total Depth _____

PRODUCTION

1st 24 hrs. Nat. _____

1st 24 hrs. after shot _____

Gas _____ Cu. Ft.

Dry Hole _____

Abandoned _____

Date

AUG 10 1949 19S. J. LEWIS

Scout

Map No. K74 Sec. 32 Twp. 25 R. 4E

Well No. 3 McCullough

E. Adair et al. Company

COMPLETE

Contractor

NW SE NW

E 11343
SECTION PLAT

	o		

_____ Ft. from N. Line

990 Ft. from S. Line

990 Ft. from E. Line

_____ Ft. from W. Line

Butler County

RECORD

Location _____

Cased _____ in., _____ ft.

Rig up _____

Sand _____

Drilling and Remarks:

Gas _____

Oil _____

Miss 2658

Total Depth 2668

7" @ 2658

Only 3500 ft BT

PRODUCTION

1st 24 hrs. Nat. _____

1st 24 hrs. after shot _____

Gas _____ Cu. Ft.

Dry Hole _____

Abandoned _____

2800 ft

Date

SEP 21 1949 19

S. J. LEWIS Scout