

KANSAS

Butler

Section 32 Township 25 Range 4E

Well No. 4 Mc Cullough

Company E. Adair et al

Misc.

NORTH

WEST

	0						

EAST

SOUTH

Butler

KANSAS

Sec. 32 Twp. 25 R. 4E

Well No. #4 McCullough Farm

E. Adair et al Company


Miscellaneous

 Ft. from N. Line

330' Ft. from S. Line

 Ft. from E. Line

990' Ft. from W. Line

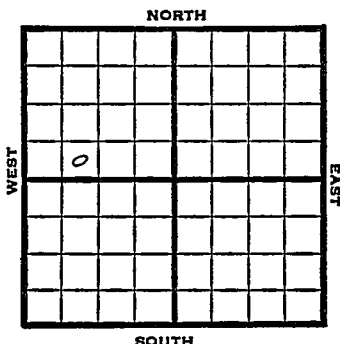

SE SW NW

1949	Elev 1300' REPORT
10/19	Machine
10/26	15" @ 142'
	Drlg. 2225'
11/1	2225 Was wrong
	Drlg 1130'
	13" @ 845'
11/9	10" @ 1655'
	Lansing 1796'
	Drlg 1875'
11/23	TD 2617'
	Viola 2609'
	7" @ 2609'
	Pump 50 Oil Pot
	38° Gr.
	Comp
	COMPLETED

Map No. _____ Sec. 32 Twp. 25 R. 4E

Well No. 4 McCullough

E. Adair et al. Company

Contractor

SE SW NW

**FIRST REPORT
SECTION PLAT**

Ft. from N. Line

330 Ft. from S. Line

Ft. from E. Line

990 Ft. from W. Line

Butler County

Location _____

Rig up _____

Drilling and Remarks: _____

Machine _____

RECORD

Cased _____ in., _____ ft.

Sand _____

Gas _____

Oil _____

Total Depth _____

PRODUCTION

1st 24 hrs. Nat. _____

1st 24 hrs. after shot _____

Gas _____ Cu. Ft.

Dry Hole _____

Abandoned _____

Date

OCT 19 1949

19

S. J. LEWIS

Scout

Map No. _____ Sec. 32 Twp. 25 R. 4E

Well No. 4 McCullough

E. Adair et al. Company

COMPLETE

Contractor

SE SW NW


E. 1300
SECTION PLAT

_____ Ft. from N. Line

330 Ft. from S. Line

_____ Ft. from E. Line.

990 Ft. from W. Line

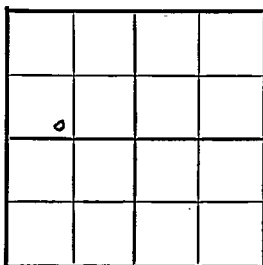

Butler County

Location _____

Rig up _____

Drilling and Remarks:

Wota 2609

7 "C2609

Run 50 oil ft.

282 ft

RECORD

Cased _____ in., _____ ft.

Sand _____

Gas _____

Oil _____

Total Depth 2617

PRODUCTION

1st 24 hrs. Nat. _____

1st 24 hrs. after shot _____

Gas _____ Cu. Ft.

Dry Hole _____

Abandoned _____

Date

NOV 23 1949 19

S. J. LEWIS Scout