

KANSAS

FORM 51 5M 4-41 PETROL

Barton

Section 10 Township 17 Range 14-W

Well No. 1 Reidle


Company Halmerich & Payne & Phillips

Wildcat

NORTH

WEST

EAST

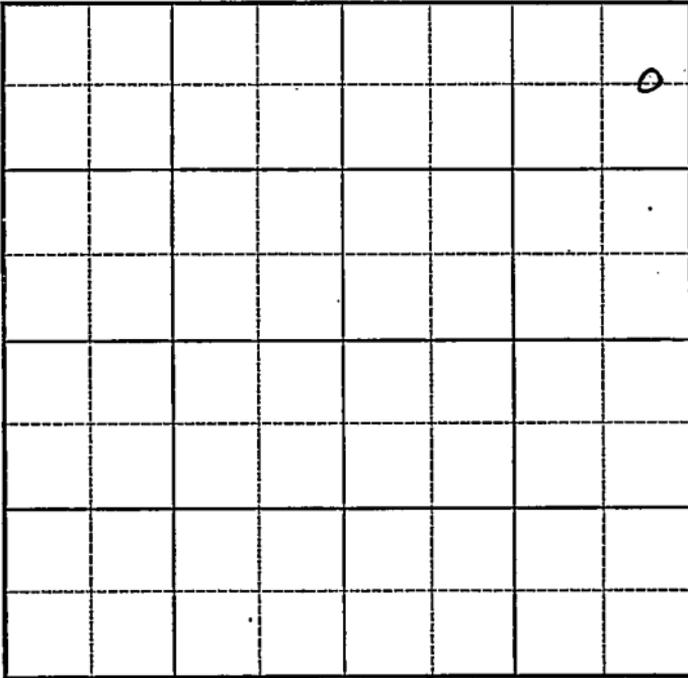

SOUTH

Map No. 73 Sec. 10 Twp. 17 R. 14WWell No. 1 ReidleHelmerich & Payne- & Phillips
Company**FIRST REPORT**

Contractor

SECTION PLAT

C E L N E N E

660 Ft. from N. Line

_____ Ft. from S. Line

330 Ft. from E. Line

_____ Ft. from W. Line

			o

WILDCAT

Location _____

Rig up _____

Drilling and Remarks:

S.H.

RECORD

Cased _____ in., _____ ft.

Sand _____

Gas _____

Oil _____

Total Depth _____

PRODUCTION

1st 24 hrs. Nat. _____

1st 24 hrs. after shot _____

Gas _____ Cu. Ft.

Dry Hole _____

Abandoned _____

Date

APR 23 1941

S. J. LEWIS Scout

Map No. 73 Sec. 10 Twp. 17 R. 14WWell No. 1 ReidlHelmerich & Payne CompanyABANDONED Contractor

C E L N E N E

660 Ft. from N. Line

_____ Ft. from S. Line

330 Ft. from E. Line

_____ Ft. from W. Line

WILD CAT

SECTION PLAT

			0

Location _____

Rig up _____

Drilling and Remarks:

*Ar 83495.**No shows*

RECORD

Cased _____ in., _____ ft.

Sand _____

Gas _____

Oil _____

Total Depth 2504

PRODUCTION

1st 24 hrs. Nat. _____

1st 24 hrs. after shot _____

Gas _____ Cu. Ft.

Dry Hole _____

Abandoned _____

Date

MAY 14 1941 19

S. J. LEWIS Scout