


Section 23 Township 16 Range 10W

Well No. 2 Zitzman

Company Don Ingling

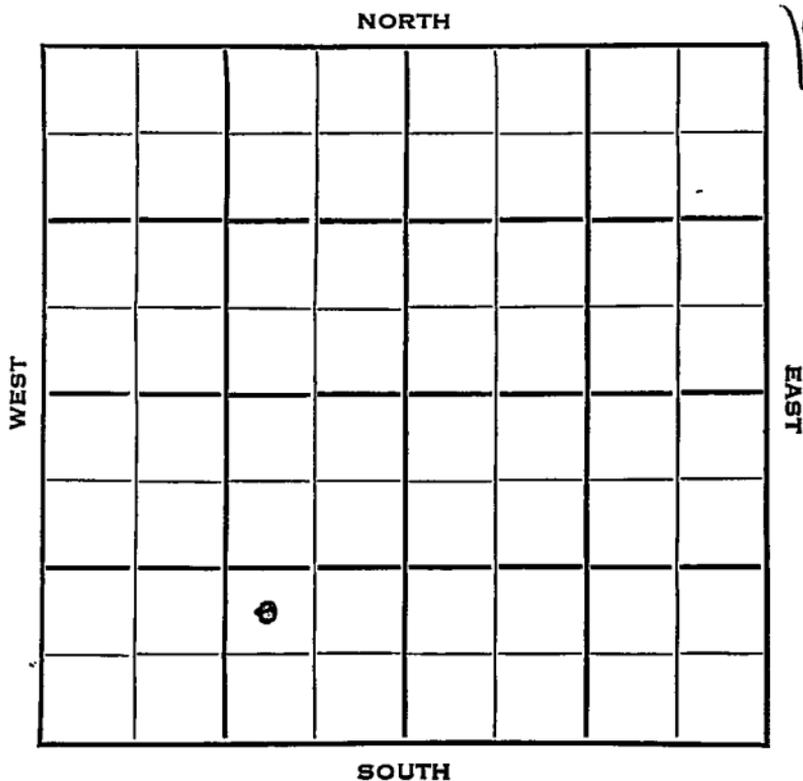

Ellsworth

KANSAS

SEC.	TWP.	R.
23	16	10W ✓

WELL NO. #2 Zitzman FARM

COMPANY Don Ingling

CONTRACTOR Don Ingling

_____ Ft. from N. Line	
990 Ft. from S. Line	
990 Ft. from E. Line	
_____ Ft. from W. Line	
NW SE SW	

	ELEVATION	REPORT
1954	1888'	
4/14	Spud 4-8-54 8" @ 255'	
4/28	Drlg 1580' Spud 4-8-54 D&A TD 3427' 8" @ 255' KC 3021', Simp. 3407' DST 3407-08', opn 1/2 hrs., rec. 10' mud 405# Arb. 3409' TD 3427' D&A	
		ABANDONED

