


Section 11 Township 17 Range 14 W

Well No. #1 Nester

Company Texas Co.

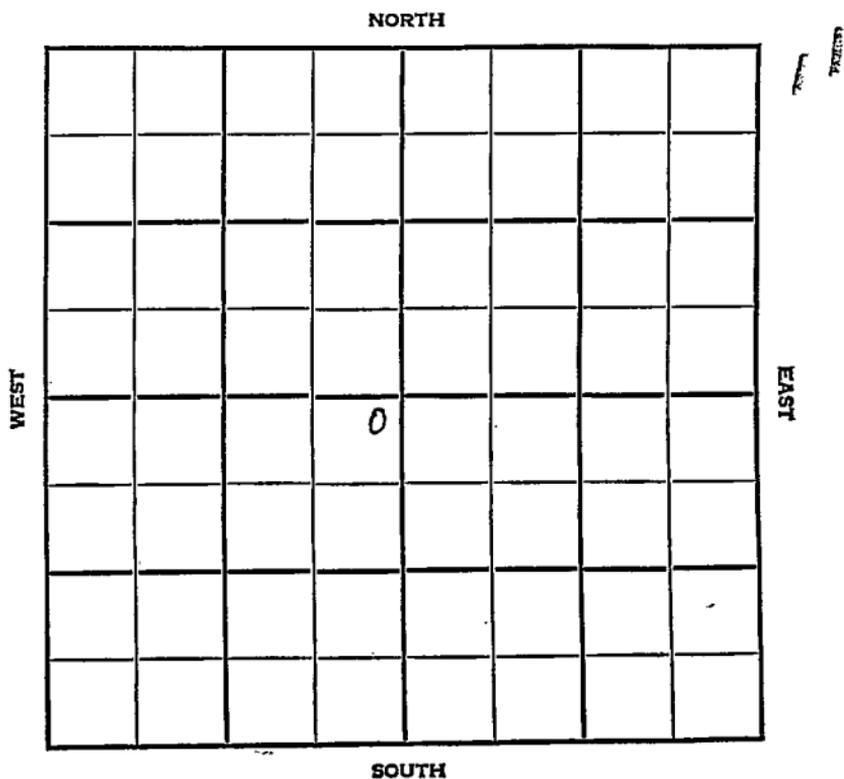

Barton

KANSAS

SEC.	11	TWP.	17	R.	11W
------	----	------	----	----	-----

WELL NO. #1 Nester FARM

COMPANY Texas Co.

CONTRACTOR Prime Drlg
Wildcat


_____ Ft. from N. Line

_____ Ft. from S. Line

380' _____ Ft. from E. Line

_____ Ft. from W. Line

NE NE SW .

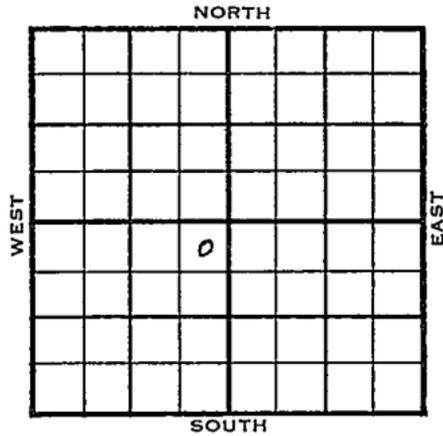

1955	ELEVATION 1922' DF	REPORT
------	-----------------------	--------

89/7 Comm 9-3-55
10" @ 888/550
Drlg 1635

9-21 DST 3167-3202 op 1 hr. rec. 12' mud,
BHP 100# 20";

D & A

<u>TOPS</u>	<u>DEPTH</u>	<u>LOG</u>
Anh		880
Tp.	2848	2853
H.	3089	3089
Tr.		3103
B.L.	3163	3163
L.	3174	3174
C.	3378	3377
A.	3439	3439
T.D.	3459'	

ABANDONED

County Barton Elev. _____
 Sec. 11 Twp. 17 Rge. 7W
 Company Texas Company
 Farm Name Nester No. 1

TOPS	DEPTH	LOG	DATUM
Anh.			
Tp.			
H.			
Tr.			
Dg.			
Bl.			
L.			
K.C.			
B.K.C.			
Ce.			
C.			
M.			
M.			
K.			
Mz.			
Mo.			
V.			
S.			
S.			
A.			
R.			
PE.			
G.			
T.D.			

Loc. in Sec. NE NE SW
380' EL.
 Geol. _____
 Contr. _____
Prime Drlg.
 Pool Wildcat

FIRST REPORT
 0
 SEP 7 '55

Date Comm. 9-3-55
10" @ 888/550 drlg. 1635

(Handwritten signature/initials)

Co. _____
 Lse. _____
 No. _____
 Sec. _____
 T. _____
 R. _____

County **Barton** Elev. **1922 DF**
 Sec. **11** Twp. **17S** Rge. **14W**
 Company **Texas Company**
 Farm Name **Nester** No. **1**

TOPS	DEPTH	LOG	DATUM	Loc. in Sec.																
Anh.		880		NE NE SW																
Tp.	2848	2853	931																	
H.	3089	3089	1167	380' EL																
Tr.		3103	1181																	
Dg.																				
Bl.	3163	3163	1211																	
L.	3174	3174	1252	Geol.																
K.C.				Contr.																
B.K.C.				Prime Drlg.																
Ce.	3378	3377	1455																	
C.				Pool																
M.																				
M.				Wildcat																
K.																				
Mz.				<table border="1"> <tr><td></td><td></td><td></td><td></td></tr> <tr><td></td><td></td><td></td><td></td></tr> <tr><td></td><td></td><td></td><td></td></tr> <tr><td></td><td></td><td></td><td></td></tr> </table>																
Me.																				
V.																				
S.																				
S.				ABANDONED																
A	3439	3439	1517																	
R.																				
PE.																				
G.																				
T.D.	3459																			

Date Comm. **9-3-55** SEP 21 1955

10" 888 w/550; DST 3167-3202 op 1 hr. rec.
 12" mud, BHP 100# 20"; D & A

Co.
 Sec.
 No.
 Sec.
 T.
 R.