


Section 15 Township 32 Range 6EWell No. #1 BolackCompany H. H. Blair McNish & Grallo

NORTH

WEST

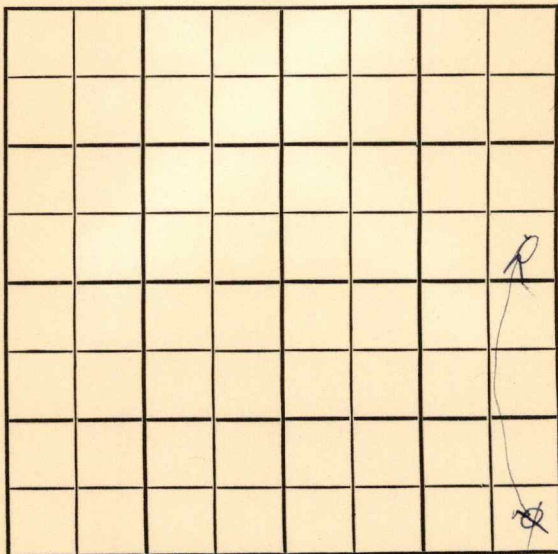

EAST

SOUTH

Cowley			KANSAS		
SEC.	TWP.	R.			
15	32	6E			

WELL NO. #1 Bolack FARM

COMPANY

CONTRACTOR ~~H.H. Blair~~ Mc NISH & GRALLOP


WILDCAT

_____ FT. FROM N. LINE

_____ FT. FROM S. LINE

_____ FT. FROM E. LINE

_____ FT. FROM W. LINE

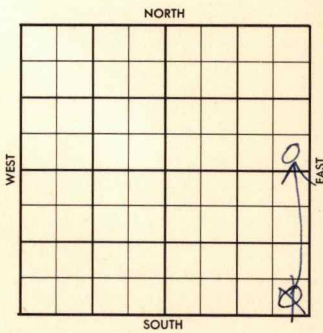

SE SE SE
NE

SDX - 5/8 mile

1956	ELEVATION	REPORT
------	-----------	--------

8-8	Location
8-13	"
8-23	"
8-30	Loc
9-7	NR

TOPS	DEPTH	LOG	DATUM	Loc. in Sec.
Anh.				SE SE SE
Tp.				
H.				
Tr.				
Dg.				
BL.				
L.				Geol.
K.C.				
B.K.C.				Contr.
Ce.				
C.				
M.				
M.				Pool
K.				Wildcat
Mz.				
Me.				
V.				
S.				
S.				
A.				
R.				
Pe.				
G.				
T.D.				

Lse

No.

5/8 mile

FIRST REPORT

AUG 8 '56

Location

AUG 1 2 1956


CORRECTION

Marked by mistake

FORM 513 SUNRAY

County Cowley Elev. 1361
 Sec. 15 Twp. 32 Rge. 6E
 Name McNiesh & Grallap
 Bolack No. 1

TOPS	DEPTH	LOG	DATUM	Loc. in Sec.
Ans.				SE SE SE
Tp. <u>stall</u>		<u>1842</u>		NE
H. <u>L. stall</u>		<u>2003</u>		
Tr. <u>lay</u>		<u>2265</u>		
Dg.				
Bl.				
L.				Geol.
K.C.		<u>2413</u>		Contr.
B.K.C. <u>13art/zn</u>		<u>2856</u>		
Ce.				
C.				
M.		<u>3037</u>		
M.				Pool
K.				Wildcat
Mz.				
Ma.				
V.				
S.				
S.				
A.				
R.				
Pe.				
G.				
T.D.	<u>3067</u>			

5/8 mile
 ABANDONED
 SEP 26 '56

Date Comm. Location
 AUG 15 '55 AUG 22 '56 AUG 29 '56
 SEP 5 '56 SEP 12 '56 SEP 19 '56
 9-10-56 8578 103 D 2162
 SEP 26 '56

DEA