

KANSAS

FORM 51 5M 10-41 PETROL


Ellsworth

Section 26 Township 16 Range 10-W

Well No. #1 Wamhoff

Company Benson Drilling


Stoltenberg Pool NORTH

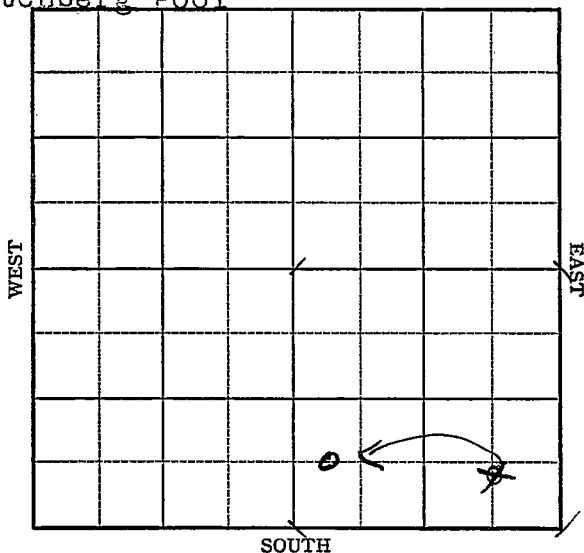

KANSAS Ellsworth

Sec. 26 Twp. 16 R. 10-WWell No. #1 Wamhoff FarmBenson Drilling Company

(Stoltenberg Pool)

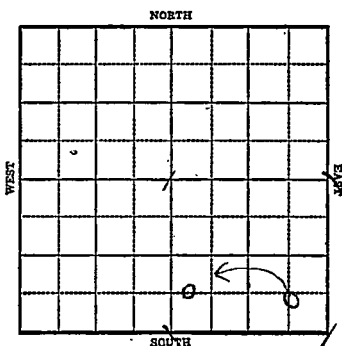 Ft. from N. Line660~~510~~ Ft. from S. Line~~660~~ Ft. from E. Line330 Ft. from W. Line

1942

R E P O R T

10/7	Location
10/14	Drlg. 310'
10/21	15" @ 324, 13" @ 495 Drlg 900'
10/28	5 1/2 10" @ 1055 FP. Riley 1610 Drlg. 1630
11/4	8" @ 1925 Drlg. 2360
11/11	Topeka 2610 TD 2655' Fishing too ls.
11/18	2830 CO
11/24	"
12/2	Arb 3206 - 3310 TD
12/9	Arp 3309 corrected 5" @ 3309 TD 3313 swb 200 oil in 10 hrs.
12/16	" " "
12/22	1500 gals. acid. Testing
12/29	" "
1943	
1/6	" "
1/13	" "

OVER

1943 TD 3313d
1/20 Arb 3209
5" Casing set 3209
1500 acid
Depth Pot. 834'
44.3 Gravity
TD 3316.

COMPLETED

Ellsworth

KANSAS

Map No. 55 Sec. 26 Twp. 16 R. 10WWell No. 1 Wamhoff

Benson Drilling


Company

~~FIRST REPORT~~

Contractor

C SESE

SECTION PLAT

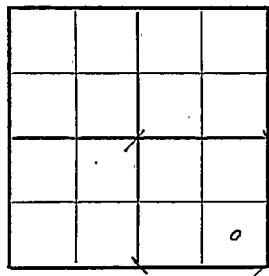

_____ Ft. from N. Line

510 Ft. from S. Line660 Ft. from E. Line

_____ Ft. from W. Line

STOLTENBERG POOL

Location XXX

Rig up _____

Drilling and Remarks:

RECORD

Cased _____ in., _____ ft.

Sand _____

Gas _____

Oil _____

Total Depth _____

PRODUCTION

1st 24 hrs: Nat. _____

1st 24 hrs. after shot _____

Gas _____ Cu. Ft.

Dry Hole _____

Abandoned _____

Date _____

OCT 7 1942 19

S. J. LEWIS Scout

Ellsworth

Map No. 55 Sec. 26 Twp. 16 R. 10 ^{KANSAS} _{LOW}Well No. 1 Wamhoff

Benson Drilling

Company

CORRECTION

Contractor

C WL SW SE

SECTION PLAT

Ft. from N. Line


660

Ft. from S. Line

Ft. from E. Line

330

Ft. from W. Line

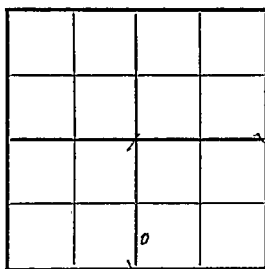

STOLTENBERG POOL

Location

Rig up

Drilling and Remarks:

*Correct
Location*

RECORD

Cased _____ in., _____ ft.

Sand _____

Gas _____

Oil _____

Total Depth _____

PRODUCTION

1st 24 hrs. Nat. _____

1st 24 hrs. after shot _____

Gas _____ Cu. Ft.

Dry Hole _____

Abandoned _____

Date

OCT 21 1942

19

S. J. LEWIS Scout

KANSAS

Map No. 55 Sec. 26 Twp. 16 R. 10WWell No. 1 WamhoffBenson Drilling CompanyCOMPLETED Contractor

C WL SW SE

SECTION PLAT

Ft. from N. Line

660 Ft. from S. Line

Ft. from E. Line

330 Ft. from W. Line

STOLTENBERG POOL

Location _____

Rig up _____

Drilling and Remarks:

*Cor 83209**5" 83209**1500 ac oil**Depth 284**44 3/4*

RECORD

Cased _____ in., _____ ft.

Sand _____

Gas _____

Oil _____

Total Depth 3316

PRODUCTION

1st 24 hrs. Nat. _____

1st 24 hrs. after shot _____

Gas _____ Cu. Ft.

Dry Hole _____

Abandoned _____

Date

JAN. 20 1943

19

S. J. LEWIS Scout