


KANSAS

Ellsworth

Section 26 Township 16 Range 10W

Well No. #1 Wamhoff

Company Alco Valve

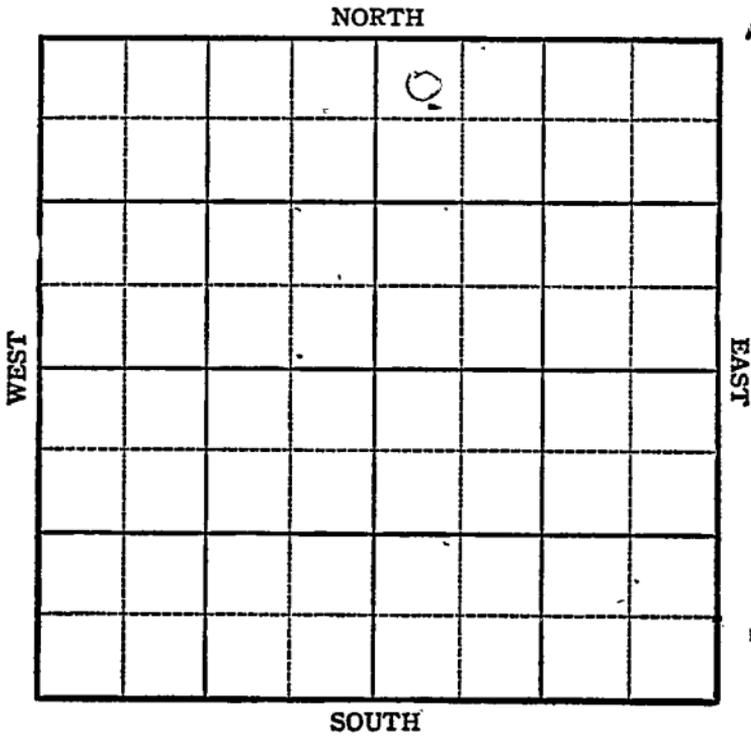

KANSAS

Ellsworth

Sec. 26 Twp. 16 R. 10W

Well No. #1 Wamhoff Farm

Alco Valve Company


Stoltenberg

480 Ft. from N. Line

_____ Ft. from S. Line

_____ Ft. from E. Line

480 Ft. from W. Line

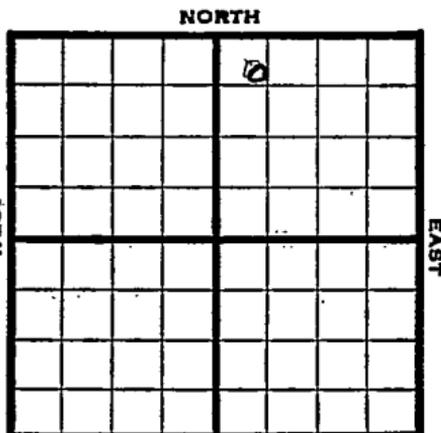

C NW NE *E (N) 1872* SOUTH

1944

REPORT

- 8/23 2 dry holes on this lease
 8" @ 240 WOC
- 8/30 Drlg. 2490
- 9/6 Arb 3400
 TD 3405

ABAK

ABANDONED

KANSAS Pool Name StoltenbergMap No. 5-5 Sec. 26 Twp. 16 R. 10WWell No. 1 WamhoffAlco Valve

Company

~~FIRST REPORT~~

Contractor


C NW NE

SECTION PLAT

480 Ft. from N. Line

Ft. from S. Line

Ft. from E. Line

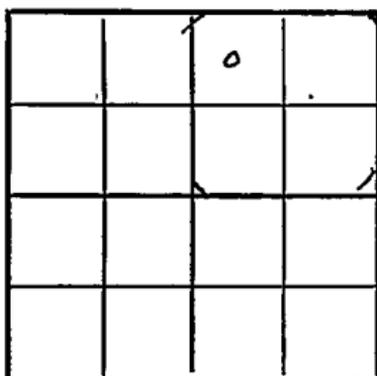480 Ft. from W. LineEllsworth County

Location _____

Rig up _____

Drilling and Remarks:

2 dry holes on
this lease

8" - 240 WOC

RECORD

Cased _____ in., _____ ft.

Sand _____

Gas _____

Oil _____

Total Depth _____

PRODUCTION

1st 24 hrs. Nat. _____

1st 24 hrs. after shot _____

Gas _____ Cu. Ft.

Dry Hole _____

Abandoned _____

Date

AUG 23 1944 19S. J. LEWIS

Scout

KANSAS

Pool Name Stoltenberg

Map No. 27 Sec. 26 Twp. 16 R. 10W

Well No. 1 Wamhoff

Alco Valve Company

ABANDONED Contractor

C NW NE

SECTION PLAT

480 Ft. from N. Line

_____ Ft. from S. Line

_____ Ft. from E. Line

480 Ft. from W. Line

		0	

Ellsworth

Location _____

Rig up _____

Drilling and Remarks:

Ce 83400

RECORD

Cased _____ in., _____ ft.

Sand _____

Gas _____

Oil _____

Total Depth 8405

PRODUCTION

1st 24 hrs. Nat. _____

1st 24 hrs. after shot _____

Gas _____ Cu. Ft.

Dry Hole _____

Abandoned _____

Date

SEP 6 1944 19

S. J. LEWIS Scout