

Butler

KANSAS

FORM 51 25M 3-49 PETROL

32

25

4E


Section _____ Township _____ Range _____

Well No. #5 McCullough

Company Adair et al

NORTH

WEST

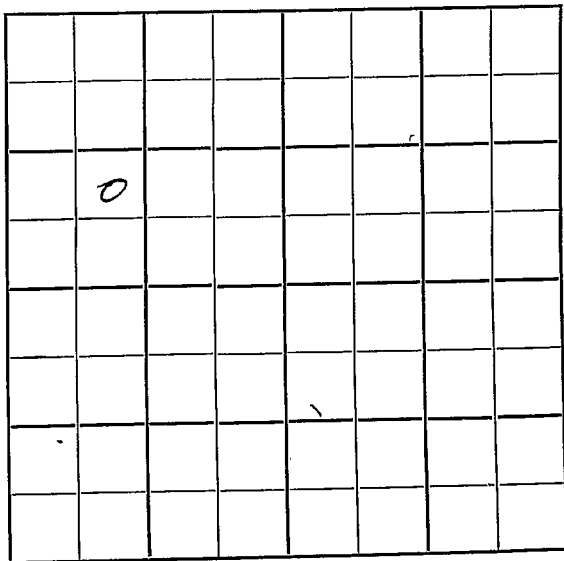

EAST

SOUTH

Butler

KANSAS

Sec. 32 Twp. 25 R. 4E

Well No. #5 McCullough Farm

Adair et al Company

White Cotton


 Ft. from N. Line

990' Ft. from S. Line

 Ft. from E. Line

990' Ft. from W. Line

NE SW NW

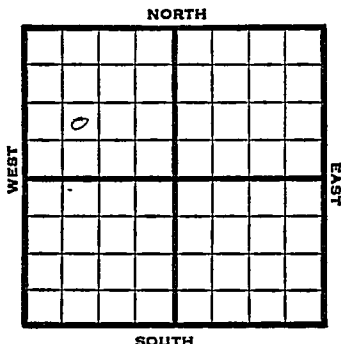

1950

Elev. 1316' REPORT

1/18

MIM

2/22

15" @ 165'

13" @ 860'

10" @ 1710'

7" @ 2622'

Chat 2510'

B. Miss 2556'

Viola 2652'

40 BOPD

TD 2654'

COMPLETED

Kansas

Map No. _____ Sec. 32 Twp. 25 R. 4EWell No. 5 McCullough

_____ Adair et al. _____ Company

_____ Contractor

NE SW NW

SECTION PLAT

o			

~~FIRST REPORT~~

_____ Ft. from N. Line

990 Ft. from S. Line

_____ Ft. from E. Line

990 Ft. from W. Line

Butler County

Location _____

Rig up _____

Drilling and Remarks:

M I M

RECORD

Cased _____ in., _____ ft.

Sand _____

Gas _____

Oil _____

Total Depth _____

PRODUCTION

1st 24 hrs. Nat. _____

1st 24 hrs. after shot _____

Gas _____ Cu. Ft.

Dry Hole _____

Abandoned _____

Date

J. E. TYRA ScoutJAN 18 1930 19

Map No. _____ Sec. ^{Kansas} 32 Twp. 25 R. 4E

Well No. 5 McCullough

Adair et al. _____ Company

Contractor _____

NE SW NW


E1. 1316
SECTION PLAT

_____ Ft. from N. Line

990 _____ Ft. from S. Line

_____ Ft. from E. Line

990 _____ Ft. from W. Line

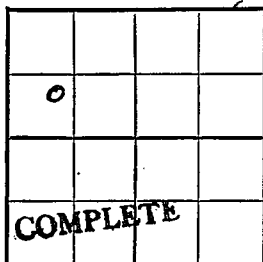

Butler County

Location _____

Rig up _____

Drilling and Remarks:

15' @ 165
13' @ 860
10' @ 1710
7' @ 2622
Chat 2510
B min 2556
Viola 2652

Date

40 B O P D

RECORD

Cased _____ in., _____ ft.

Sand _____

Gas _____

Oil _____

Total Depth 2654

PRODUCTION

1st 24 hrs. Nat. _____

1st 24 hrs. after shot _____

Gas _____ Cu. Ft.

Dry Hole _____

Abandoned _____

FEB 22 1950 19

J. E. TYRA Scout