


Section 23 Township 16 Range 10W

Well No. #1 Zitzmann

Company D.T. Ingling et al

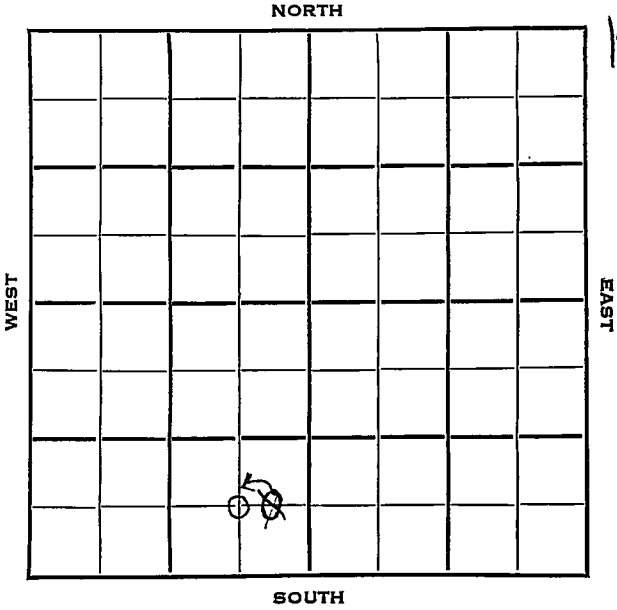

Ellsworth

KANSAS

SEC.	TWP.	R.
23	16	10 W ✓

WELL NO.

I Zitzmann

FARM

COMPANY

D. T. Ingling et al

CONTRACTOR


Ingling

_____ Ft. from N. Line

660 _____ Ft. from S. Line

660
~~330~~ _____ Ft. from E. Line

_____ Ft. from W. Line

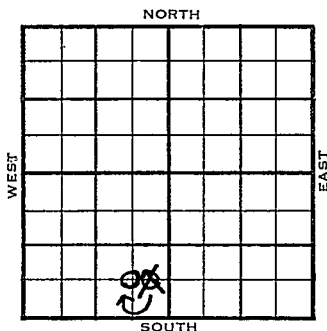~~C-E-L~~ SE SW

	ELEVATION	REPORT
1954	1873'	
1/6	MIR	
1/13	8" @ 262'	
	Drlg. 1800'	
1/20	Lans 3003'	
	DST 3095-3100, 1/2 hrs., 55' O&GCM,	
	1040#	
	Drlg.	
1/27	RTD 3384'	
	4" @ 3379'	
2/3	Marm 3308', Arb 3382'	
2/10	NR	
3/24	supd 1-7-54	
	Oil Well	
	TD 3384'	
	8" @ 262'	
	Lans 3003'	
	DST 3095-3100', opn 1/2 hrs., rec. 55'	
	o & gcm, 1040#	
	TD 3384'	
	4" @ 3379'	
	Marm. 3308', Arb. 3382'	
	CO to 3383', 30 bf 2 day 20% wtr.	
	20/3379-80, S/6 bfph 40% wtr.	
	Comp. 15 bopd 15 bw	

J. G. McGEHEE

Kansas

Map No. _____ Sec. 23 Twp. 16 R. 10WWell No. 1 Zitzman

D. T. Ingling

Company

CORRECTION

Contractor

C SE SW

SECTION PLAT

	9		

_____ Ft. from N. Line

660 Ft. from S. Line660 Ft. from E. Line

_____ Ft. from W. Line

Ellsworth County

Location _____

Rig up _____

Drilling and Remarks:

Reported

C EL SE SW

RECORD

Cased _____ in., _____ ft.

Sand _____

Gas _____

Oil _____

Total Depth _____

PRODUCTION

1st 24 hrs. Nat. _____

1st 24 hrs. after shot _____

Gas _____ Cu. Ft.

Dry Hole _____

Abandoned _____


Date

JAN 13 1954

19

J. G. McGEHEE Scout

County Ellsworth State Kansas
 Sec. 23 (Blk.) 16 (Sur.) 10W Map No.
 Operator D. T. Ingling et al.
 Well No. 1 Farm Zitzmann
 Elev. 1873 Location C SE SW

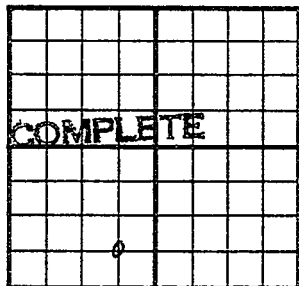

660 Ft. From S Line SW
660 Ft. From E Line Quarter

1st. Report

Completion MAR 24 1954

Remarks

Ingling - Contr.

Spudding Date 1-7-54

Drilg. Data Oil well TD 3384

8" @ 262 Lans. 3003 DST 3095-3100

open $\frac{1}{2}$ hr. Rec. 55' o & gcm 1040#

TD 3384 4" @ 3379 Marm. 3308

Arb. 3382 CO to 3383 30 bf 2 day

20% wtr. 20/ 3379-80 S/ 6 bfph

40% wtr. Comp. 15 bopd 15 bw

J. G. McGEHEE