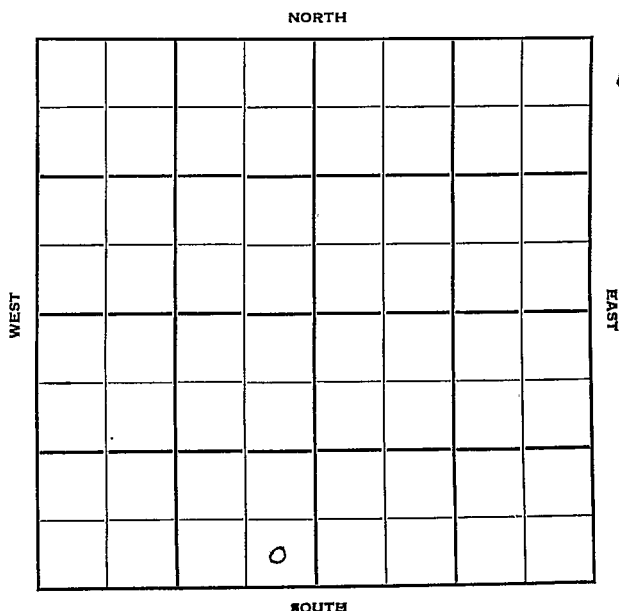


Section 11 Township 17 Range 14-WWell No. #1 HesterCompany Skelly Oil

KANSAS
17

Barton

Sec. 11 Twp. 17 R. 14-W ✓

Well No. #1 Hester Farm

Skelly Oil Company

Wildcat Contractor


 Ft. from N. Line

330 Ft. from S. Line

330 Ft. from E. Line

 Ft. from W. Line

SE SE SW

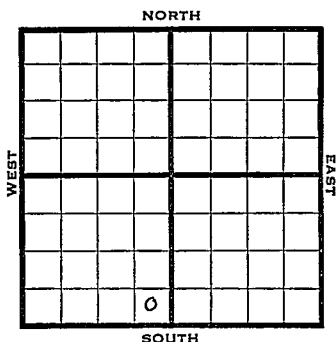

1950 Elev 1903 REPORT

7/12 Spud 7-8-50
Anhy 859
8" @ 869

7/26 WOC
Anhy 859
8" @ 869
Heeb 3078 Lans 3146
Cong 3362
DST 3377-87 opn 30 min, rec mud
Arb 3379
TD 3444
D&A

ABANDONED

Kansas

Wildcat

Map No. _____ Sec. 11 Twp. 17 R. 14WWell No. 1 Hester

_____ Skelly Oil _____ Company

_____ Contractor

SE SE SW


E 1. 1903

SECTION PLAT

_____ Ft. from N. Line

330 Ft. from S. Line330 Ft. from E. Line

_____ Ft. from W. Line

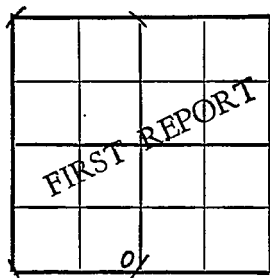

Barton County

Location _____

Rig up _____

Drilling and Remarks:

Spud 7-8-50

Anhy 859

8" @ 869

WOC

RECORD

Cased _____ in., _____ ft.

Sand _____

Gas _____

Oil _____

Total Depth _____

PRODUCTION

1st 24 hrs. Nat. _____

1st 24 hrs. after shot _____

Gas _____ Cu. Ft.

Dry Hole _____

Abandoned _____

Date

JUL 12 1950 19J. E. TYRA Scout

Map No. _____ Sec. 11 Twp. 17 R. 14WWell No. 1 HesterSkelly Oil

Company

Contractor


SE SE SW

E1. 1903
SECTION PLAT

_____ Ft. from N. Line

330 Ft. from S. Line330 Ft. from E. Line

_____ Ft. from W. Line

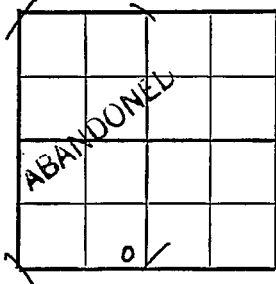Barton County

Location _____

Rig up _____

Drilling and Remarks:

Anhy 859

8" @ 869

Heeb. 3078

Lans. 3146

Cong. 3362

DST 3377-87

open 30 min.

RECORD

Cased _____ in., _____ ft.

Sand _____

Gas _____

Oil _____

Total Depth 3444

PRODUCTION

1st 24 hrs. Nat. _____

1st 24 hrs. after shot _____

Gas _____ Cu. Ft.

Dry Hole _____

Abandoned _____

Date

JUL 26 1950 19J. E. TYRA Scout