

Section 11 Township 17 Range 11 W

Well No. # 4 Hester

Company Skelly Oil

NORTH

○							

12

WEST

EAST

SOUTH

Barton

Sec. 11 Twp. 17 R. 14W

Well No. #4 Hester Farm

Skelly Oil Company

Contractor

Larkin Pool


660' Ft. from N. Line

\_\_\_\_\_ Ft. from S. Line

\_\_\_\_\_ Ft. from E. Line

330' Ft. from W. Line

C W L NW SW

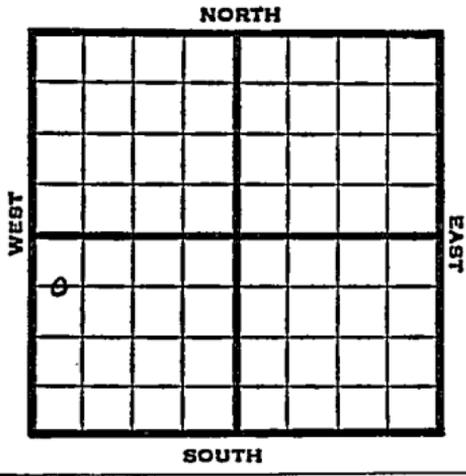

1951

Elev. 1957' REPORT

5/29

Location

7/11

SWD Well TD 3683  
 8" @ 931  
 Anhy 920 Heeb. 3120  
 Tor. 3132 Br Lime 3190  
 Lams. 3200  
 DST 3245-75 opn 1/2 hr Rec. 6' mud  
 DST 3269-82 opn 1 hr. Rec. 55'  
 wtr & mud Cong. 3421  
 Arb. 3449-3683 TD  
 5" @ 3485 FU 2580 wtr  
 4000 A Comp. for SWD well  
**ABANDONED**

County Barton State Kansas

Sec. 11 (Blk. 17) (Sur. 14W) (Twp.) (Rge.) Map No.

Operator Skelly Oil

Well No. 4 Farm Hester

Elev. Location C W L NW SW


660 Ft. From N Line SW

330 Ft. From W Line Quarter

Ist. Report MAY 29 1951

Completion \_\_\_\_\_

Remarks \_\_\_\_\_

Spudding Date \_\_\_\_\_

Drlg. Data Larkin Pool

Location

J. E. TYRA

County Barton State Kansas

Sec. 11 (<sup>Blk.</sup>     <sup>Twp.</sup>    ) 17 (<sup>Sur.</sup>     <sup>Rge.</sup>    ) 14W Map No.

Operator Skelly Oil

Well No. 4 Farm Hester

Elev. 1957 Location C W L NW SW


660 Ft. From N Line SW

330 Ft. From W Line Quarter

Ist. Report

Completion JUL 11 1951

Remarks Larkin Pool

Spudding Date

Drlg. Data SWD well TD 3683

8" @ 931 Anhy 920 Heeb. 3120

Tor. 3132 Br. line 3190 Lans. 3200

DST 3245-75 open  $\frac{1}{2}$  hr. Rec. 6' mud

DST 3269-82 open 1 hr. Rec. 55'

water & mud Cong. 3421 Arb. 3449-

3683 TD 5" @ 3485 FU 2580' water

4000 A Compl for SWD well