

KANSAS

Form 51-5M-7-39-Palace,

Ellsworth

Section 26 Township 16 Range 10-W

Well No. #1 Schroeder

Company Magnolia


Ehler Pool

NORTH

WEST

EAST

SOUTH

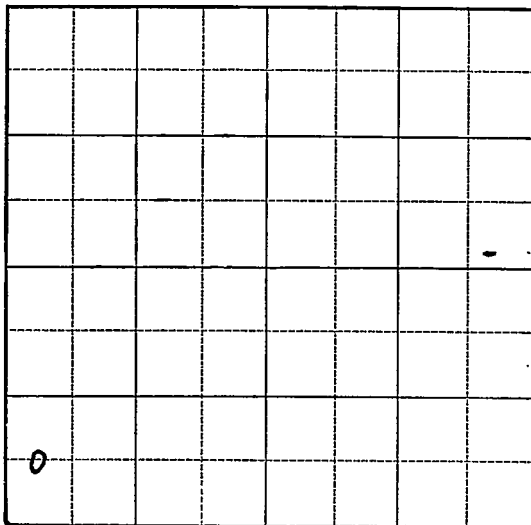

KANSAS


Ellsworth

Sec. 26 Twp. 16 R. 10-WWell No. #1 Schroeder FarmMagnolia Company

(Ehler)

 Ft. from N. Line660 Ft. from S. Line Ft. from E. Line330 Ft. from W. Line

Elev. 1824

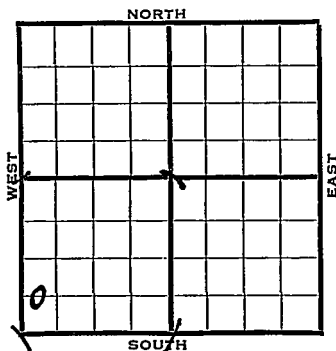

1940	REPORT
6/29	Derrick.
6/27	10" - 222'
	Drlg. 740'
7/3	Drlg. 1817'
7/11	Drlg. 3028'
7/18	Arb. 3281 7" 3281 TD 3282 HFO
7/18	Top Arbuckle 3281 7" 3281 T.D. 3282
	Drilled plugs Filled up with oil in
	2 hours Will drill deeper (Tel)
7/24	Arb. 3280'
	7" - 3280'
	T.D. 3284'
	1000 acid.
	Depthograph potential 8791 bbls.
	Maximum 3000 bbls.
	COMPLETED

Map No. 55 Sec. 26 Twp. 16 R. 10WWell No. 1 SchroederMagnolia

Company

Contractor


FIRST REPORT

C W L SW SW

 Ft. from N. Line660 Ft. from S. Line Ft. from E. Line330 Ft. from W. Line

EELER POOL

SECTION PLAT

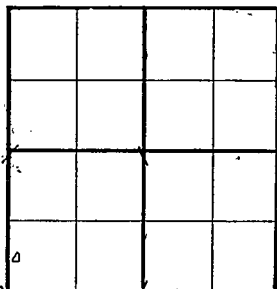Location Rig up

Drilling and Remarks:

Derrick

RECORD

Cased in., ft.Sand Gas Oil Total Depth

PRODUCTION

1st 24 hrs. Nat. 1st 24 hrs. after shot Gas Cu. Ft.Dry Hole Abandoned

Date

JUN 19 1940

19

S. J. LEWIS Scout

Map No. _____ Sec. **26** Twp. **16** R. **10W**Well No. **1 Schroeder****Magnolia**

Company _____

Contractor _____

COMPLETED**SECTION PLAT****C W L SW SW**

_____ Ft. from N. Line

660 Ft. from S. Line

_____ Ft. from E. Line

330 Ft. from W. Line**EHLER POOL**

Location _____

Rig up _____

Drilling and Remarks:

*Ar 8280**7" @ 3280**1000 acid**Depth graph k Rd**579**Map 3000***RECORD**

Cased _____ in., _____ ft.

Sand _____

Gas _____

Oil _____

Total Depth **3284****PRODUCTION**

1st 24 hrs. Nat. _____

1st 24 hrs. after shot _____

Gas _____ Cu. Ft.

Dry Hole _____

Abandoned _____

Date

JUL 24 1940**S. J. LEWIS** Scout