


Section 26 Township 16 Range 10-WWell No. #2 SchroederCompany Magnolia

NORTH Ehler Pool

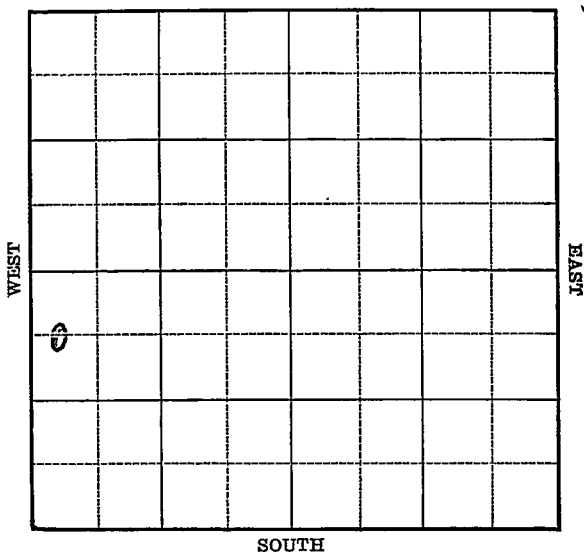

KANSAS

Ellsworth


FORM 252-A 5M 2-40

Sec. 26 Twp. 16 R. 10-WWell No. #2 Schroeder FarmMagnolia Company

(Ehler)

660 Ft. from N. Line Ft. from S. Line Ft. from E. Line330 Ft. from W. Line

Elev. 1839

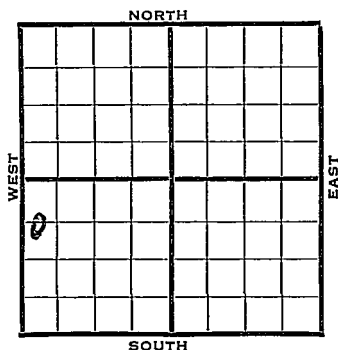

1940

REPORT

7/24

Location

8/2

10" - 307' WOC.

8/8

Drlg. 2090'

8/14

Drlg. 3137'

8/22

Lans. 2987' Simp. 3288'

Arb. 3298' 5" - 3298'

T.D. 3303' Swab 63 bbls. per

hour 4 hrs. off bottom.

8/28

Arb. 3298 5" 3298 T.D. 3303

500 acid

Echometer Pot. 4497

Maximum 3000

COMPLETED

Map No. _____ Sec. 26 Twp. 16 R. 10WWell No. 2 SchroederMagnolia Company

Contractor

FIRST REPORT

SECTION PLAT

C W L NW SW

660 Ft. from N. Line

_____ Ft. from S. Line

_____ Ft. from E. Line

330 Ft. from W. Line

o			

EHLER POOL

Location X

Rig up _____

Drilling and Remarks:

RECORD

Cased _____ in., _____ ft.

Sand _____

Gas _____

Oil _____

Total Depth _____

PRODUCTION

1st 24 hrs. Nat. _____

1st 24 hrs. after shot _____

Gas _____ Cu. Ft.

Dry Hole _____

Abandoned _____

Date

JUL 24 1940 19S. J. LEWIS Scout

Map No. _____ Sec. 26 Twp. 16 R. 10W

Well No. 2 Schroeder

Magnolia Company

Contractor

COMPLETED
C W L NW SW

SECTION PLAT

660 Ft. from N. Line

_____ Ft. from S. Line

_____ Ft. from E. Line

330 Ft. from W. Line

2			

EHLER POOL

Location _____

Rig up _____

Drilling and Remarks:

Ar 8298
5" C 3298.
500 acid
Echmetes 128
4497
May 1940

RECORD

Cased _____ in., _____ ft.

Sand _____

Gas _____

Oil _____

Total Depth 3303

PRODUCTION

1st 24 hrs. Nat. _____

1st 24 hrs. after shot _____

Gas _____ Cu. Ft.

Dry Hole _____

Abandoned _____

Date

AUG 28 1940 19

S I LEWIS Scout