

KANSAS

Form 51-5M-7-40-Palace

Ellsworth

Section 26 Township 16 Range 10-W

Well No. #3 Schroeder


Company Magnolia

Ehler Pool

NORTH

WEST

EAST

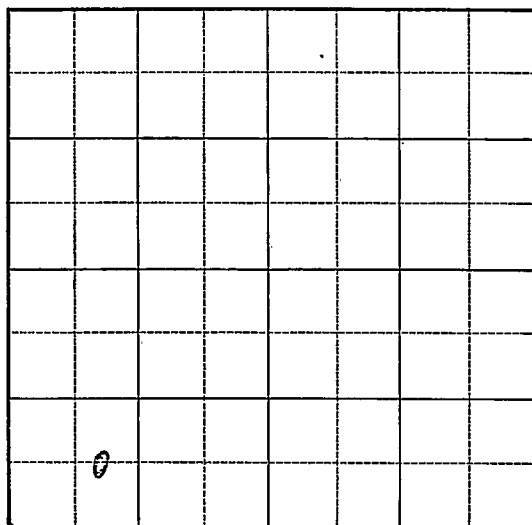

SOUTH

Map No. 55 Sec. 26 Twp. 16 R. 10WWell No. 3 SchroederMagnolia Company

Contractor

FIRST REPORT

C E L SW SW

 Ft. from N. Line660 Ft. from S. Line Ft. from E. Line990 Ft. from W. Line

EHLER POOL

SECTION PLAT

0			

Location XRig up

Drilling and Remarks:

RECORD

Cased in., ft.Sand Gas Oil Total Depth

PRODUCTION

1st 24 hrs. Nat. 1st 24 hrs. after shot Gas Cu. Ft.Dry Hole Abandoned

Date

SEP 18 1940

19

S. J. LEWIS Scout

Map No. 53 Sec. 26 Twp. 16 R. 10WWell No. 3 SchroederMagnolia

Company

Contractor

COMPLETED

C E L SW SW

 Ft. from N. Line660 Ft. from S. Line Ft. from E. Line990 Ft. from W. Line

EHLER POOL

SECTION PLAT

Location Rig up

Drilling and Remarks:

*CR 83288**5" @ 8289**Echler R 83642**Nov 3000***RECORD**Cased in., ft.Sand Gas Oil Total Depth 8295**PRODUCTION**1st 24 hrs. Nat. 1st 24 hrs. after shot Gas Cu. Ft.Dry Hole Abandoned

Date

OCT 23 1940 19

S. I. LEWIS Scout