

KANSAS

Form 51—5M—7-40—Palace


Ellsworth

Section 26 Township 16 Range 10-W

Well No. #4 Schroeder

Company Magnolia

NORTH Stoltenberg Pool

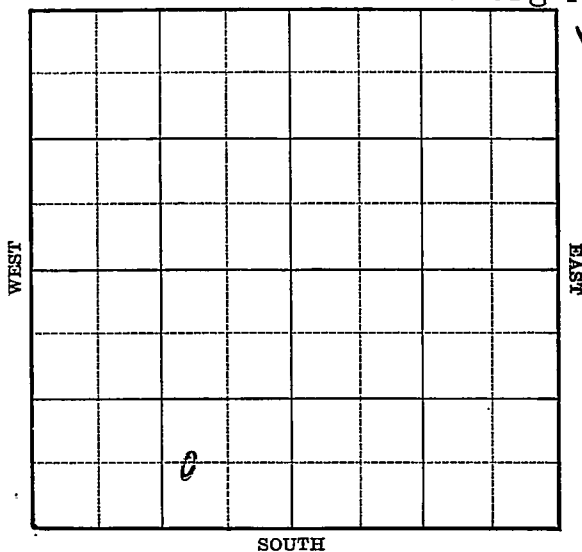

KANSAS


Ellsworth

Sec. 26 Twp. 16 R. 10-WWell No. #4 Schroeder FarmMagnolia Company

(Stoltenberg)

 Ft. from N. Line660 Ft. from S. Line990 Ft. from E. Line Ft. from W. Line

Elev. 1839

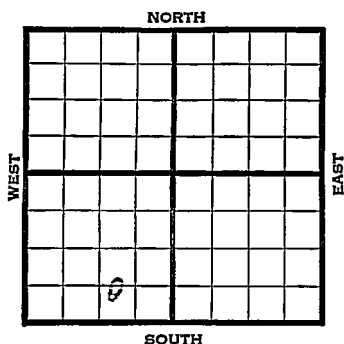

1940

REPORT

11/6

Location

11/14

Derrick.

11/21

10" - 247' WOC.

11/27

Drlg. 2000'

12/5

Drlg. 3121'

12/12

Arb. 3308' 5" - 3309' T.D.

Swab 30 bbls. in 7 hours.

12/18

Arb. 3308'

5" - 3309'

T.D. 3316'

1000 acid.

Echometer potential 37,013 bbls.

Maximum 3000 bbls.

44.3 Gravity

COMPLETED

Map No. 55 Sec. 26 Twp. 16 R. 10WWell No. 4 SchroederMagnolia Company

Contractor

FIRST REPORT

C W L SE SW

 Ft. from N. Line660 Ft. from S. Line990 Ft. from E. Line Ft. from W. Line**STOLTENBERG POOL****SECTION PLAT**

	D		

Location XRig up

Drilling and Remarks:

RECORDCased in., ft.Sand Gas Oil Total Depth **PRODUCTION**1st 24 hrs. Nat. 1st 24 hrs. after shot Gas Cu. Ft.Dry Hole Abandoned

Date

NOV 6 1940 19 S. J. LEWIS Scout

Map No. 55 Sec. 26 Twp. 16 R. 10WWell No. 4 SchroederMagnolia Company

Contractor

COMPLETED

C W L SE SW

 Ft. from N. Line660 Ft. from S. Line990 Ft. from E. Line Ft. from W. Line

STOLTENBERG POOL

SECTION PLAT

			.
	o		

Location Rig up

Drilling and Remarks:

*Cor 83308**5" @ 3309.**1000 acid**Echd 833013**Max 3000**44.2 Gr.***RECORD**Cased in., ft.Sand Gas Oil Total Depth 3216**PRODUCTION**1st 24 hrs. Nat. 1st 24 hrs. after shot Gas Cu. Ft.Dry Hole Abandoned

Date

DEC 18 1940

S. J. LEWIS

Scout