

KANSAS

Form 51-5M-7-40-Palace


Ellsworth

Section 26 Township 16 Range 10-W

Well No. #5 Schroeder

Company Magnolia

NORTH Stoltenberg Pool

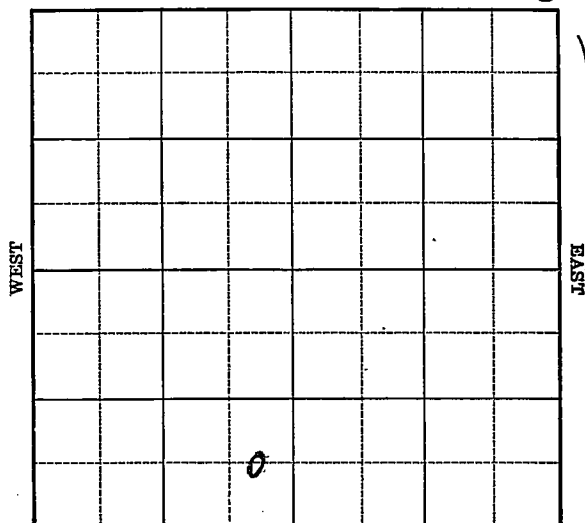

SOUTH

Sec. 26 Twp. 16 R. 10-W

Well No. #5 Schroeder Farm

Magnolia _____ Company

(Stoltenberg)


Ft. from N. Line

660 Ft. from S. Line

330. Ft. from E. Line

____Ft. from W. Line

Elev. 1843

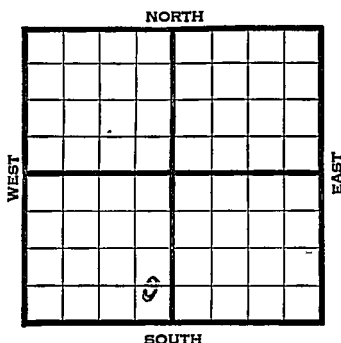[illegible]

Map No. 55 Sec. 26 Twp. 16 R. 10WWell No. 5 SchroederMagnolia

Company

Contractor

FIRST REPORT

C E L S E S W

 Ft. from N. Line660 Ft. from S. Line330 Ft. from E. Line Ft. from W. Line

STOLTENBERG POOL

SECTION PLAT

Location Rig up

Drilling and Remarks:

10" - 251 WOC**RECORD**Cased in., ft.Sand Gas Oil Total Depth **PRODUCTION**1st 24 hrs. Nat. 1st 24 hrs. after shot Gas Cu. Ft.Dry Hole Abandoned Date DEC 11 194019S. J. LEWIS

Scout

Map No. 55 Sec. 26 Twp. 16 R. 10WWell No. 5 SchroederMagnolia

Company

Contractor

COMPLETED**SECTION PLAT**

C E L S E S W

Ft. from N. Line

660

Ft. from S. Line

330

Ft. from E. Line

Ft. from W. Line

STOLTENBERG POOL

Location _____

Rig up _____

Drilling and Remarks:

*Cr 83318**5" 83318**1000 acid**Ech 8 849732**May 3000**440 Dr***RECORD**

Cased _____ in., _____ ft.

Sand _____

Gas _____

Oil _____

Total Depth 3324**PRODUCTION**

1st 24 hrs. Nat. _____

1st 24 hrs. after shot _____

Gas _____ Cu. Ft.

Dry Hole _____

Abandoned _____

Date

JAN 8 1941

S. J. LEWIS Scout