


Barton

KANSAS

Section 12 Township 17 Range 14W

Well No. #1 Peltz (B)

Company Derby Drig.

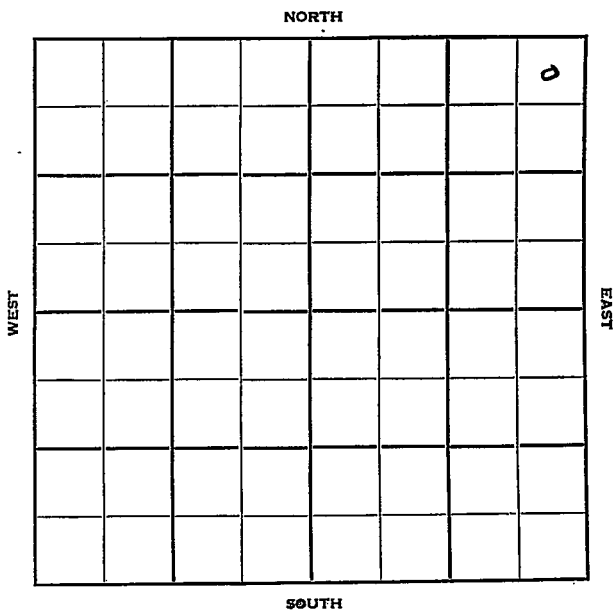

Sec. 12 Twp. 17 R. 14W

Well No. #1 Peltz (B) Farm

Derby Drlg. Company

Rocket - Contr. Contractor


330' Ft. from N. Line

_____ Ft. from S. Line

330' Ft. from E. Line

_____ Ft. from W. Line

NE NE NE

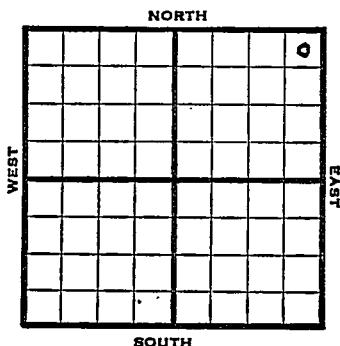

1952 Elev. 1993' REPORT

7/2 Spud 6-30-52
8" @ 270
WOC

7/9 Topeka 2913 Heeb. 3149
Br Li 3225 Lans. 3233
DST 3229-67

7/17 1 hr. 80' VSO&GCM
DST 3277-92 1 hr. 120' muddy oil &
50' HO&GCM 160#
DST 3306-12 3/4 hr. 5' M 930#
DST 3358-76 1 1/2 hr. 65' WCM 900#
Cong 3447 Arb. 3477
DST 3479-89 1 hr. 5' M 350#
RTD 3505 5" @ 3490
12/3309-13 500 A B/10 galoph

7/23 12/3312-16 1500 A S/ 1 1/2 Bo &
1/2 Bwph for 8 hrs. PB 3304
24/ 3295-3302 1000 A 5 Bfph
S/ 2 Bfph for 6 hrs. 55% oil
24/ 3281-88 to A

7/30 2500 A P/8 BOPH for 3 hrs.
8/6 NR

8/13 Spud 6-30-52
Oil Well TD 3505' 8" @ 270'
Top. 2913 Heeb. 3149
Br Li 3225 Lans. 3233

OVER

1952

8/13 DST 3229-67 open 1 hr. rec. 80'
VSO & GCM Off
DST 3277-92 open 1 hr. rec. 120'
muddy oil 50' HO&GCM 160#
DST 3306-12 open 3/4 hr. rec. 5'
mud 930#
DST 3358-76 open 1 1/2 hr. rec. 65'
wcm 900# Cong. 3447 Arb. 3477
DST 3479-89 open 1 hr. rec. 5' mud
350# TD 3505 5" @ 3490
12/3309-13 500 A B/ 10 goph
12/3312-16 1500 A S/ 1 1/2 bo
1/2 bwph PB 3304 2 1/4/ 3295-3302
1000 A 5 bfph S/ 2 bfph 55% oil
2 1/4/ 3281-88 2500 A F/ 8 boph
Comp. 397 bopd 6% wtr.

COMPLETED

