

KANSAS

Form 51—5M—7-40—Palace


Ellsworth

Section 26 Township 16 Range 10-W

Well No. #6 Schroeder

Company Magnolia

NORTH Stoltzenberg Pool

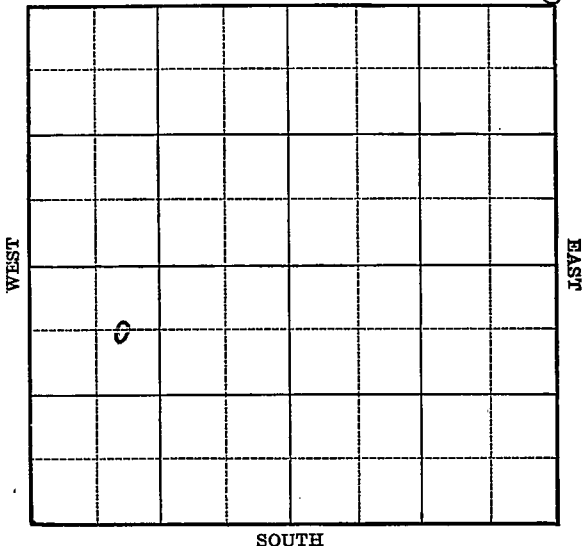

KANSAS

Ellsworth

Sec. 26 Twp. 16 R. 10-WWell No. #6 Schroeder FarmMagnolia Company

(Stoltenberg)


660 Ft. from N. Line

Ft. from S. Line

Ft. from E. Line

990 Ft. from W. Line

Elev. 1827

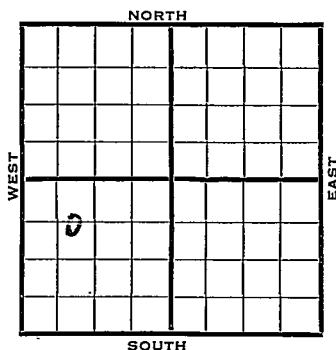

1941

REPORT

1/22

Rotary.

1/30

10" - 308' Drlg. 1525'

2/6

Drlg. 3040'

2/13

Arb. 3306-08' T.D. 5" - 3307'

RUST.

2/19

Arb. 3306'

5" - 3307'

T.D. 3317'

1500 acid.

Water.

ABANDONED

Map No. 55 Sec. 26 Twp. 16 R. 10WWell No. 6 SchroederMagnolia

Company

~~FIRST REPORT~~

Contractor

SECTION PLAT

C E L NW SW

660 Ft. from N. Line Ft. from S. Line Ft. from E. Line990 Ft. from W. Line**STOLTENBERG POOL**Location Rig up

Drilling and Remarks:

Rotary**RECORD**Cased in., ft.Sand Gas Oil Total Depth **PRODUCTION**1st 24 hrs. Nat. 1st 24 hrs. after shot Gas Cu. Ft.Dry Hole Abandoned

Date

JAN 22 191119S. J. LEWIS Scout

Map No. _____ Sec. 26 Twp. 16 R. 10WWell No. 6 Schroeder_____ Magnolia _____ Company

_____ Contractor

ABANDONED

C E L NW SW

660 Ft. from N. Line

_____ Ft. from S. Line

_____ Ft. from E. Line

990 Ft. from W. Line**SECTION PLAT**

STOLTENBERG POOL

Location _____

Rig up _____

Drilling and Remarks:

*Cr & 3306**5" @ 3307**1500 acid**Water.***RECORD**

Cased _____ in., _____ ft.

Sand _____

Gas _____

Oil _____

Total Depth 3317**PRODUCTION**

1st 24 hrs. Nat. _____

1st 24 hrs. after shot _____

Gas _____ Cu. Ft.

Dry Hole _____

Abandoned _____

Date

FEB 19 1941 19

S. J. LEWIS Scout