


Section 26 Township 16 Range 10 W

Well No. #1 Stoltanberg

Company Ken Mattson

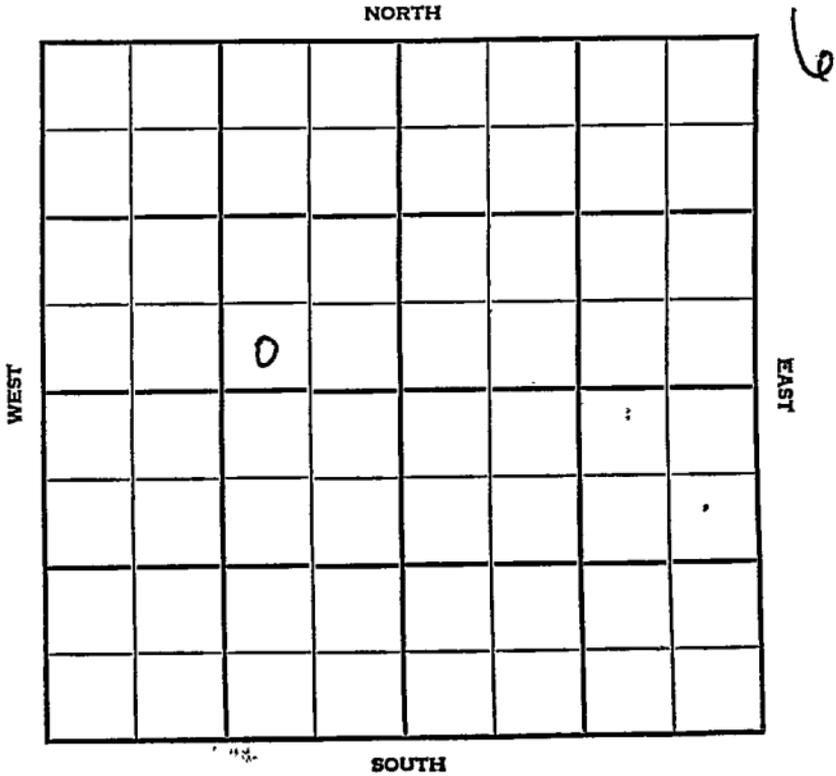

Ellsworth

KANSAS

SEC. 26	TWP. 16	R. 10W
------------	------------	-----------


WELL NO. #1 Stoltenberg FARM

COMPANY Ken Mattson

CONTRACTOR Sterling

Stoltenberg

_____ Ft. from N. Line
 _____ Ft. from S. Line
 _____ Ft. from E. Line
 _____ Ft. from W. Line

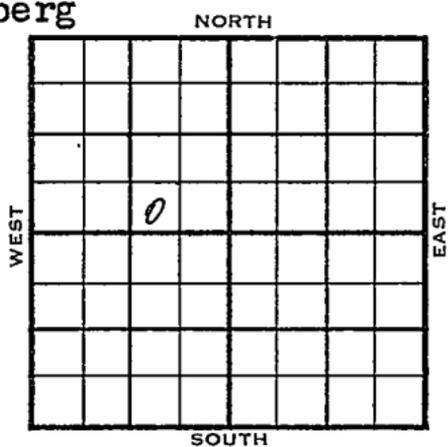

SW SE NW

1956	ELEVATION	REPORT
------	-----------	--------

2-8	MIR	
-----	-----	--

County Ellsworth Elev. _____
 Sec. 26 Twp. 16 Rge. 10W
 Company Ken Mattson
 FarmName Stoltenberg No. I

TOPS	DEPTH	LOG	DATUM	Loc. in Sec.
Anh.				SW SE NW
Tp.				
H.				
Tr.				
Dg.				
Bl.				
L.				
K.C.				Geol. _____
B.K.C.				Contr. _____
Ce.				<u>Sterling</u>
C.				Pool <u>Stoltenberg</u>
M.				
M.				
K.				
Mz.				
Mo.				
V.				
S.				
S.				
A.				
R.				
Pf.				
G.				
T.D.				

FIRST REPORT
 10
 FEB 3 '58

Date Comm. M I R

[Handwritten signature]

Co.
 Lse.
 No.
 Sec.
 T.
 R.

County Ellsworth Elev 1844
 Sec. 26 Twp. 16 Rge. 10W
 Company Ken Mattson
 Farm Name Stoltenberg No. 1

TOPS	DEPTH	LOG	DATUM	Loc. in Sec.
				SW SE NW
	2871			
	2979		1135	Geol.
	3312		1468	Cont.
				Sterling
				Pool
				Stoltenberg
	3349		1503	
	3356			ABANDONED

FEB 29 1956

Date Comm. **MIR FEB 15 '56 2-7-56 8 7/8 328**
1200 @ 2720 FEB 22 '56 FEB 29 '56 DST
3350-56 1 hr run 25' SW BHP
840/20" No Log

W. A. Hold