


Cowley KANSAS

Section 16 Township 32 Range 6 E

Well No. # 2 C. Bolack

Company Laura Jane Oil Co.

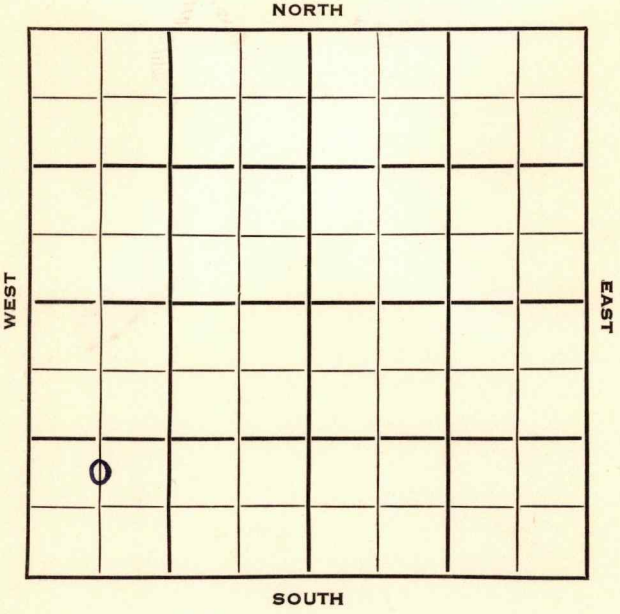

Cowley

KANSAS ✓

Sec. 16 Twp. 32 R. 6E

Well No. #2 C. Bolack Farm

Laura Jane Oil Company Company

Contractor

Wildcat.


Ft. from N. Line

990 Ft. from S. Line

Ft. from E. Line

660 Ft. from W. Line

N/2 SW SW
Atlantic - DHM

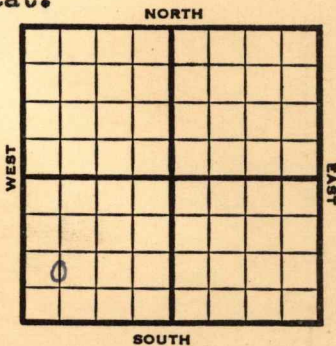

1953

Elev. -

REPORT

7/14

Spudding

7/29

D&A

TD 3087

8" @ 104

Br lime 1847, Stal 1877, Layton 2251,
KC 2458, swego 2655, Cherokee 2791,
Bart 2891, Miss 3072

TD 3087

D&A

ABANDONED


County Cowley State Kansas

Sec. 16 (Blk. 32 (Sur. 6E (Twp.) 32 (Rge.) 6E Map No.

Operator Laura Jane Oil

Well No. 2 Farm C. Bolack

Elev. _____ Location C N L SW SW

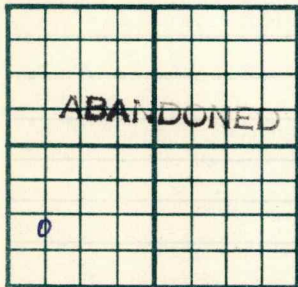

990 Ft. From S Line SW

660 Ft. From W Line Quarter

1st. Report

Completion JUL 29 1953

Remarks Wildcat

Spudding Date


Drlg. Data D & A TD 3087

8" @ 104 Br. lime 1847 Stal. 1877

Layton 2251 KC 2458 Oswego 2655

Cherokee 2791 Bart. 2891 Miss. 3072

TD 3087

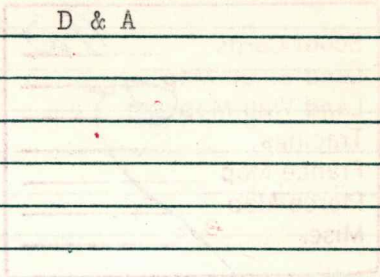

D & A