

Section 13 Township 17 Range 14WWell No. #1 Prudential LoanCompany Doley Oil

NORTH

0							

WEST

EAST

SOUTH

5

Barton

KANSAS

Sec. 13 Twp. 17 R. 14W

Well No. #1 Prudential Loan Farm

Doley Oil Company

Muffin Drlg. Contractor

Wildcat


Ft. from N. Line

330' Ft. from S. Line

Ft. from E. Line

330' Ft. from W. Line

SW SW NW

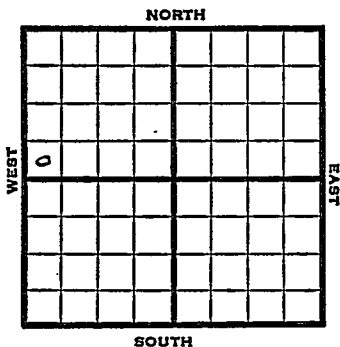

1951

Elev. 1972' REPORT

4/4

Location

6/13

Spud 5-25-51

D & A TD 3531' 8" @ 158

Heeb 3146' KC 3218'

DST 3283-3305 open 20 min. rec 8' mud

B KC 3433' Cong 3438'

DST 3433-56 open 1 hr. rec 180' SW

Arb. 3506' TD 3531' D & A

ABANDONED

County Barton State KansasSec. 13 (Blk. Twp.) 17 (Sur. Rge.) 14W Map No.Operator Doley OilWell No. 1 Farm Prudential LoanElev. Location SW SW NW

0							

FIRST REPORT

330 Ft. From S Line NW330 Ft. From W Line Quarter1st. Report APR 4 1951


Completion

Remarks

Spudding Date

Drlg. Data WildcatLocation

J. E. TYRA

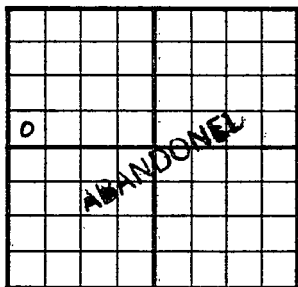County Barton State KansasSec. 13 (^{Blk.}_{Twp.}) 17 (^{Sur.}_{Rge.}) 14W Map No.Operator Doley OilWell No. 1 Farm Prudential LoanElev. 1972 Location SW SW NW330 Ft. From S Line NW330 Ft. From W Line Quarter1st. Report JUN 13 1951Completion JUN 13 1951Remarks WilicatMurfin Drlg. - Contr.Spudding Date 5-25-51Drlg. Data D & A TD 35318" @ 158 Heeb. 3146 KC 3218DST 3283-3305 open 20 min.Rec. 8' mud B KC 3433 Cong. 3438DST 3433-56 open 1 hr. Rec. 180'sw Arb. 3506 TD 3531D & A

J. E. TYRA