

KANSAS

Ellsworth

FORM 51 5M PETROL

Section 26 Township 16 Range 10WWell No. 1 StoltenbergCompany Artmell

		0					

NORTH

WEST

EAST

SOUTH

3

Sec. 26 Twp. 16 R. 10-W

Well No. #1 Stoltenberg Farm


Artmell Company

330 Ft. from N. Line

 Ft. from S. Line

990 Ft. from E. Line

 Ft. from W. Line

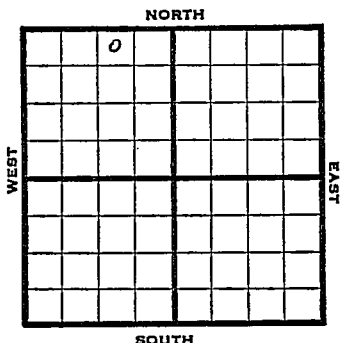

NW NE NW

1945 Elev. 1807 ~~1414~~ REPORT

10/24 Location

10/31 "

11/7 RUR

11/14 10" @ 310

Drig. 1798'

11/21 Lans 2995

TD 3000

7" @ 3000' RUST

11/28 " " "

12/5 " "M "

12/12 " " "

12/20 " " "

12/29 " " "

1946

1/10 " " "

1/17 Drig. 3160'

1/24 Cong 3360' Drig. 3370'

1/30 Miss. 2253

5" @ 2253


TD 2278' HFW

ABANDONED

KANSASPool Name StoltenbergMap No. 55 Sec. 26 Twp. 16 R. 10WWell No. 1 StoltenbergArtmell Company**FIRST REPORT**

Contractor

NW NE NW

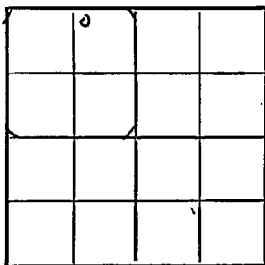SECTION PLAT330 Ft. from N. Line Ft. from S. Line990 Ft. from E. Line Ft. from W. LineEllsworth CountyLocation XRig up

Drilling and Remarks:

RECORDCased in., ft.Sand Gas Oil Total Depth **PRODUCTION**1st 24 hrs. Nat. 1st 24 hrs. after shot Gas Cu. Ft.Dry Hole Abandoned

Date

OCT 24 1945

19

S. J. LEWIS

Scout

KANSASPool Name StoltenbergMap No. 50 Sec. 26 Twp. 16 R. 10WWell No. 1- StoltenbergArtmell

Company

ABANDONED

Contractor

NW NE NW

E1.1414
SECTION PLAT330 Ft. from N. Line Ft. from S. Line990 Ft. from E. Line Ft. from W. Line

	0		
		6	
		1	

Ellsworth County**RECORD**Location Cased in., ft.Rig up Sand

Drilling and Remarks:

Gas Oil Total Depth 2275**PRODUCTION**1st 24 hrs. Nat. 1st 24 hrs. after shot Gas Cu. Ft.Dry Hole Abandoned

Date

JAN 30 1946

19

S. J. LEWIS

Scout