


Section 16 Township 32 Range 6E

Well No. #1-A C.A. Bolack

Company Laura Jane Oil

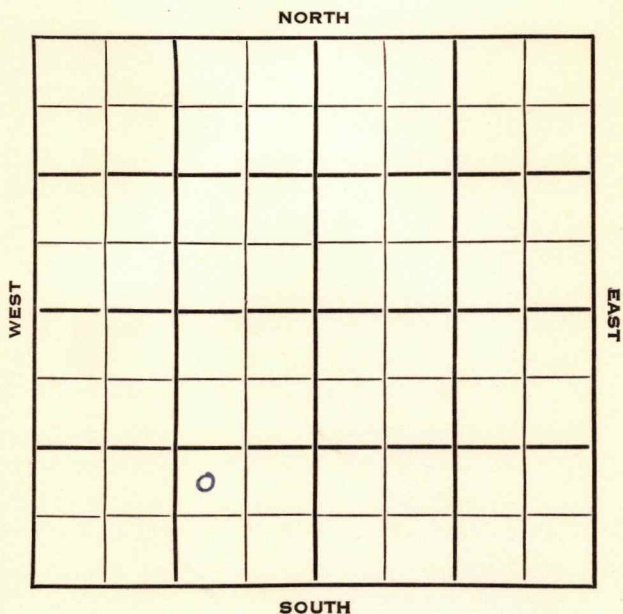

Cowley KANSAS

Sec. 16 Twp. 32 R. 6 E

Well No. # 1-A C. A. Bolack Farm

Laura Jane Oil Company

Laura Jane Wildcat Contractor

Ft. from N. Line


990 Ft. from S. Line

990 Ft. from E. Line

Ft. from W. Line

NW SE SW

Atl. DHM & BHM

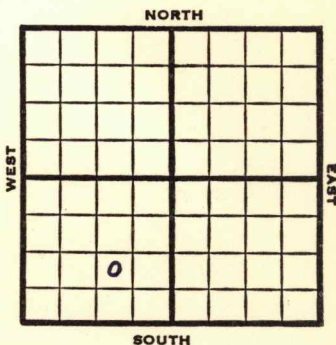

1953

Elev. 1309'

REPORT

Miss Test

4/22

Spud 4-11-53
8" @ 88 WOC

5/27

Spud 4-11-53
D&A
TD 3126
8" @ 88

Layton 2263, KC 2475, Oswego 2668,
B. Oswego 2816, Bart 2908, Bart Sd
2925

TD 3126

5" @ 3126

CO to 3126

11/2946-52, 2 bfph mostly wtr.

SP 2942

10/2936-40, 2 bfph 12hrs.

Shut in 10 hrs.

FU 800' fluid

3/2 bwph & SSO, Hydro

30 bwph 20/2936-40, 12 gw 1 hrs.

Hydro

1 1/2 boph 8 bwph SP 2927

24/2910-18, oil & wtr.

62/2932-58, 3 bwph 1/2 bo

D&A

ABANDONED

