

KANSAS

Ellsworth


Form 51—5M—7-39—Palace

Section 26 Township 16 Range 10-W

Well No. #1 Emilie Stoppel

Company Barnsdall

NORTH Stoltenberg Pool

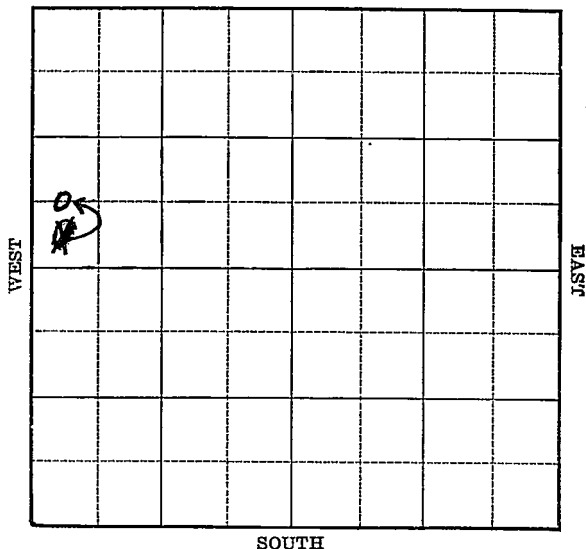


Company

(Stoltenberg)

330 Ft. from W. Line

Elev. 1849

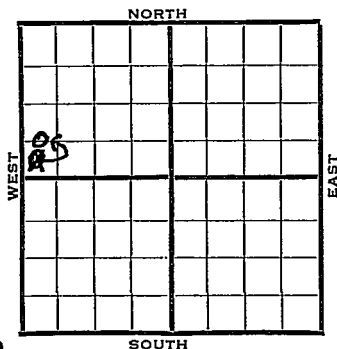[illegible]

Map No. 55 Sec. 26 Twp. 16 R. 10WWell No. 1 Emilie StoppelBarnsdall

Company

Contractor

FIRST REPORT

SW NW

 Ft. from N. Line330 Ft. from S. Line Ft. from E. Line330 Ft. from W. Line

SECTION PLAT

0			

STOLTENBERG POOL

Location XRig up

Drilling and Remarks:

RECORD

Cased in., ft.Sand Gas Oil Total Depth

PRODUCTION

1st 24 hrs. Nat. 1st 24 hrs. after shot Gas Cu. Ft.Dry Hole Abandoned

Date

MAR 27 1940 19

S. J. LEWIS

Scout

Map No. 55 Sec. 26 Twp. 16 R. 10WWell No. 1 Emilie StoppelBarnsdall

Company

CORRECTION

Contractor

SECTION PLAT

C W L SW NW

 Ft. from N. Line660 Ft. from S. Line Ft. from E. Line330 Ft. from W. Line

STOLTENBERG POOL

o			

Location Rig up

Drilling and Remarks:

Reported

SW NW

RECORD

Cased in., ft.Sand Gas Oil Total Depth

PRODUCTION

1st 24 hrs. Nat. 1st 24 hrs. after shot Gas Cu. Ft.Dry Hole Abandoned

Date

APR 3 1940

19

S. L. LEWIS Scout

Map No. 55 Sec. 26 Twp. 16 R. 10WWell No. 1 Emilie StoppelBarnsdall

Company

Contractor

ABANDONED

C W L SW NW

Ft. from N. Line

660 Ft. from S. Line

Ft. from E. Line

330 Ft. from W. Line**STOLTENBERG POOL****SECTION PLAT**

b			

Location _____

Rig up _____

Drilling and Remarks:

*Cor & 335-6**No shows***RECORD**

Cased _____ in., _____ ft.

Sand _____

Gas _____

Oil _____

Total Depth 3369**PRODUCTION**

1st 24 hrs. Nat. _____

1st 24 hrs. after shot _____

Gas _____ Cu. Ft.

Dry Hole _____

Abandoned _____

Date

. APR 17 1940 19

S. J. LEWIS

Scout