
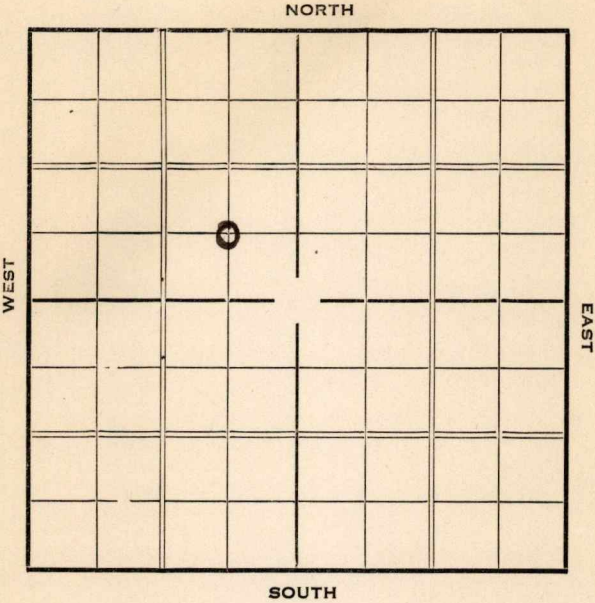


Section 21 Township 32 Range 5-E

Well Number 1 - Moon Gas

Company W. M. McNabb

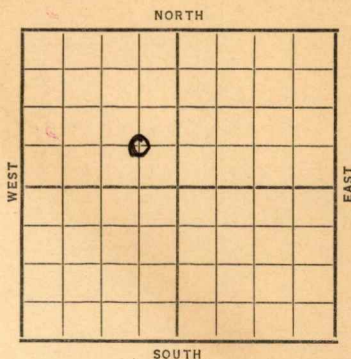

Sec. 21 Twp. 32 R. 5-EWell No. #1 Moon Gas FarmW. M. McNabb Company Ft. from N. Line660 Ft. from S. Line660 Ft. from E. Line Ft. from W. Line

Date

REPORT

1937

5/12 T.D. 260

Rng. 10".

5/14

5/21 Drlg. 690'.

5/26 Sand 690'.

T.D. 695'.

250,000 gas.

COMPLETED

COWLEY KANSAS

Map No. 2 Sec. 21 Twp. 32 R. 5EWell No. 1 - Moon GasW. M. McKnabb Company

Contractor

FIRST REPORT

SECTION PLAT

 Ft. from N. Line660 Ft. from S. Line660 Ft. from E. Line Ft. from W. Line

	0		

Location Rig up

Drilling and Remarks:

T.D. 260
Rng 10"

RECORD

Cased in., ft.Sand Gas Oil Total Depth

PRODUCTION

1st 24 hrs. Nat. 1st 24 hrs. after shot Gas Cu. Ft.Dry Hole Abandoned

Date

MAY 12 1937 19 H. D. Hatfield Scout

Cowley **KANSAS**Map No. 2 Sec. 21 Twp. 32 R. 5EWell No. 1-Moon GasW. M. McKnabb Company

Contractor

COMPLETED**SECTION PLAT**

	0		

 Ft. from N. Line660 Ft. from S. Line660 Ft. from E. Line Ft. from W. LineLocation Rig up

Drilling and Remarks:

250,000 gas**RECORD**Cased in., ft.Sand 690Gas Oil Total Depth 695**PRODUCTION**1st 24 hrs. Nat. 1st 24 hrs. after shot Gas Cu. Ft.Dry Hole Abandoned

Date

MAY 26 1937

19

H. D. Hatfield

Scout