


Butler KANSAS

Section 32 Township 25 Range 4E

Well No. #6 McCullough

Company Adair et al

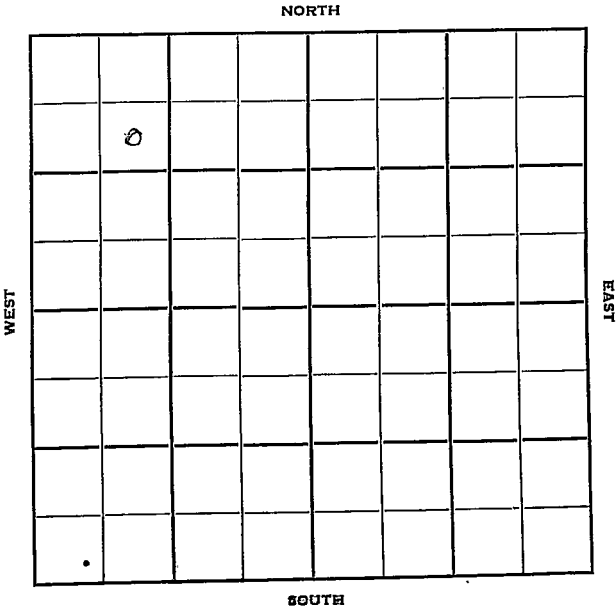

Butler

Sec. 32 Twp. 25 R. 4E ✓

Well No. #6 McCullough Farm

Adair et al Company

Contractor

Miscellaneous


990' Ft. from N. Line

_____ Ft. from S. Line

_____ Ft. from E. Line

990' Ft. from W. Line

SE NW NW

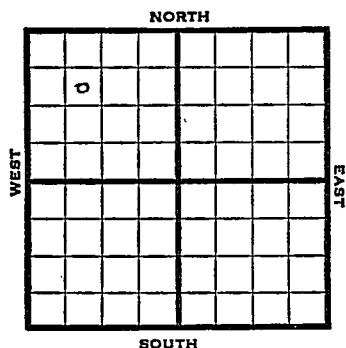

1950

Elev 1302'

REPORT

2/22

RUR

4/5

TD 2631'

15"@ 145'

13"@ 830'

Lans 1800'

8"@ 2240'

Viola 2628'

7"@ 2628'

D&A

Aband.

ABANDONED

Map No. _____ Sec. 32 Twp. 25 R. 4EWell No. 6 McCullough_____ Adair et al. _____ Company

_____ Contractor

SE NW NW


990 Ft. from N. Line

_____ Ft. from S. Line

_____ Ft. from E. Line

990 Ft. from W. Line

SECTION PLAT

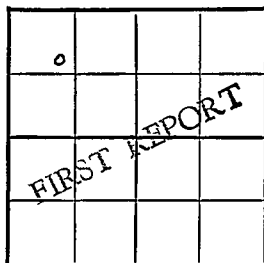Butler County

Location _____

Rig up _____

Drilling and Remarks:

R U R

RECORD

Cased _____ in., _____ ft.

Sand _____

Gas _____

Oil _____

Total Depth _____

PRODUCTION

1st 24 hrs. Nat. _____

1st 24 hrs. after shot _____

Gas _____ Cu. Ft.

Dry Hole _____

Abandoned _____

Date

J. E. TYRA

FEB 22 1950 19

Scout

Map No. _____ Sec. 32 Twp. 25 R. 4EWell No. 6 McCulloughAdair etal.

Company _____

Contractor _____

SE NW NW


E. 1302
SECTION PLAT990 Ft. from N. Line

_____ Ft. from S. Line

_____ Ft. from E. Line

990 Ft. from W. Line

Butler County

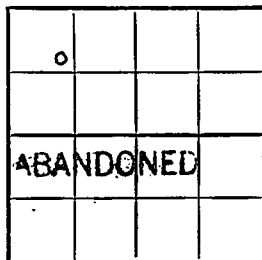

Location _____

Rig up _____

Drilling and Remarks:

15" @ 145
 13" @ 830
 Sand 1800
 8" @ 2240
 Viola 2628
 7" @ 2628
 D & A

RECORD

Cased _____ in., _____ ft.

Sand _____

Gas _____

Oil _____

Total Depth 2631

PRODUCTION

1st 24 hrs. Nat. _____

1st 24 hrs. after shot _____

Gas _____ Cu. Ft.

Dry Hole _____

Abandoned _____

Date

APR 5 1950

J. E. TYRA

Scout