


Section 32 Township 25 Range 14-E

Well No. #7 McCullough

Company Rex & Morris

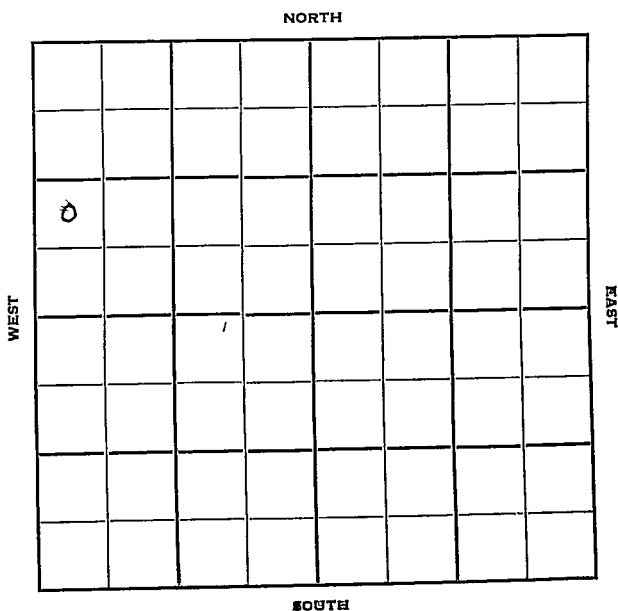

Sec. 32 Twp. 25 R. 4E

Well No. #7 McGullough Farm

Rex & Morris Company

Contractor

White Water Pool


_____ Ft. from N. Line

990' Ft. from S. Line

_____ Ft. from E. Line

330' Ft. from W. Line

NW SW NW

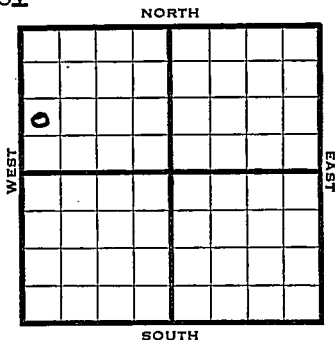

1950

Elev. 1287' REPORT

8/23

RUR

9/20,

Spud 8-25-50
 Oil Well TD 2602'
 15" @ 205' 13" @ 875'
 10" @ 1560'
 Lens. 1805'
 8" @ 2225'
 Miss 2470'
 Lime 2490'
 Viola 2593'
 7" @ 2593'
 TD 2602'
 Comp. 35 BOPD

COMPLETED

County Butler State Kansas

Sec. 32 (Blk. Twp.) 25 (Sur. Rge.) 4E Map No.

Operator Rex & Morris

Well No. 7 Farm McGullough

Elev. _____ Location NW SW NW

0					
FIRST REPORT					

990 Ft. From S Line NW

330 Ft. From W Line Quarter

1st. Report AUG 23 1950

Completion _____

Remarks _____

Spudding Date _____

Drlg. Data White Water Pool

RUR

