


Section 32 Township 25 Range 4E

Well No. #8 McCullough

Company Rex & Morris

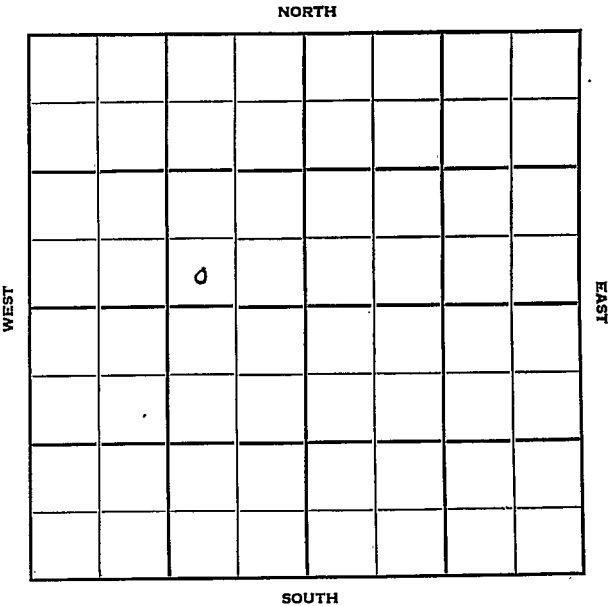

Butler

KANSAS

Sec. 32 Twp. 25 R. 4E

Well No. #8 McCullough Farm

Rex & Morris Company

Contractor


Ft. from N. Line

330' Ft. from S. Line

990' Ft. from E. Line

Ft. from W. Line

SW SE NW (Twin Well)

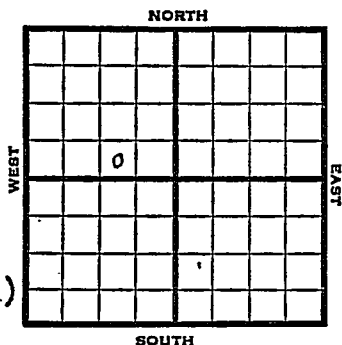

1951

Elev. 1315' REPORT

4/4

RUR

5/9

Spud 4-9-51

D&A TD 2717

15" @ 165'

13" @ 850

8" @ 2215


Chat 2510 Viola 2632

Simp 2692-2717 TD

D&A

ABANDONED

J. E. TYRA

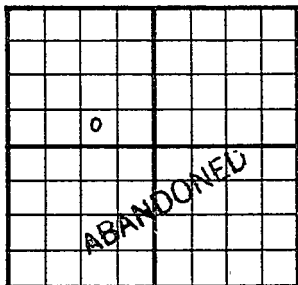County Butler State KansasSec. 32 (Blk.
Twp.) 25 (Sur.
Rge.) 4E Map No.Operator Rex & MorrisWell No. 8 Farm McCulloughElev. 1315 Location SW SE NW330 Ft. From S Line NW990 Ft. From E Line Quarter

1st. Report _____

Completion MAY 9 1951

Remarks _____

Spudding Date 4-9-51Drlg. Data D & A TD 271715" @ 165 13" @ 850 8" @ 2215Chat 2510 Viola 2632 Simp. 2692-2717 TDD & A

J. E. TYRA