


DX 78-1

Butler County, Kansas

Section 21 Township 25S Range 1E

Well No. #2 Albers

Company White & Ellis

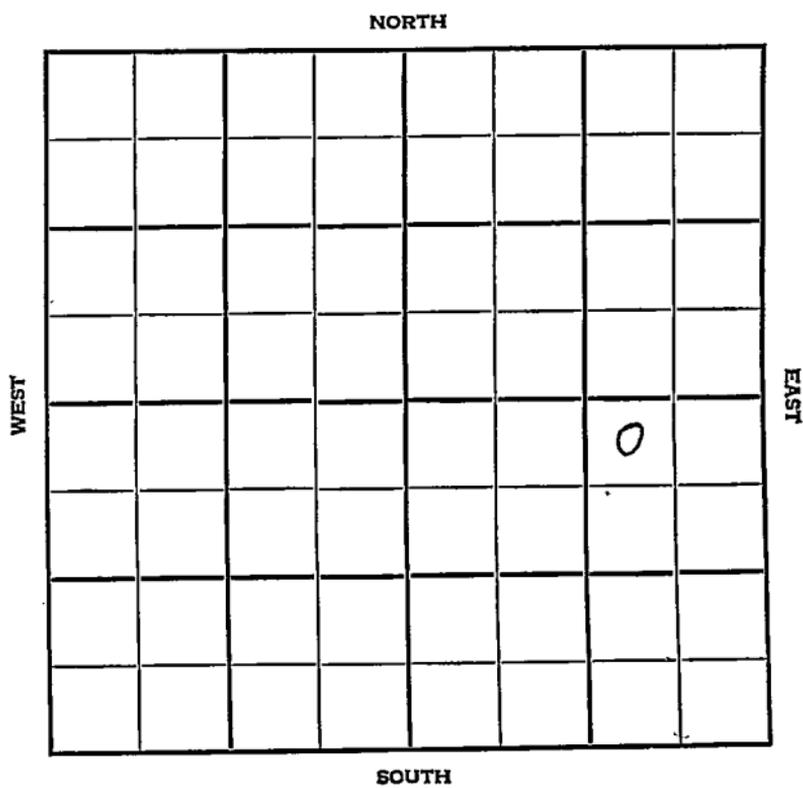

Butler

KANSAS

SEC. 21	TWP. 25	R. 4E
------------	------------	----------

WELL NO. **#2 Albers** FARM

COMPANY **White & Ellis**

CONTRACTOR

Pierce


_____ Ft. from N. Line

_____ Ft. from S. Line

_____ Ft. from E. Line

_____ Ft. from W. Line

NW NE SE

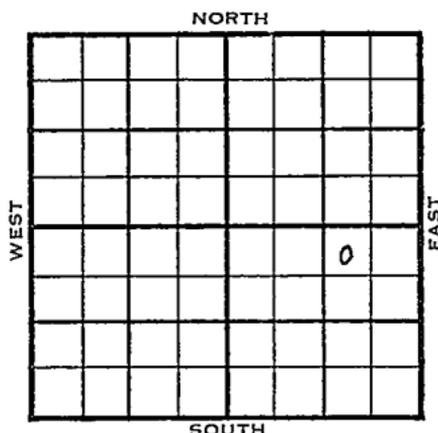

1955	ELEVATION	REPORT
------	-----------	--------

1348'

9-14 Comm. 9-13-55
Spudding

10-19 Comm 9-14-55
8" @ 105/70
5" @ 2561

Dg	1625
L	1844
KC	2126
BKC	2282
M	2559
TD	2562
DD	2574

frac
Comp 20 BOPD

COMPLETED

County Butler Elev. _____
 Sec. 21 Twp. 25 Rge. 1E
 Company White & Ellis
 FarmName Albers No. 2

TOPS	DEPTH	LOG	DATUM
Anh.			
TP.			
H.			
Tr.			
Dg.			
Bl.			
L.			
K.C.			
B.K.C.			
Ce.			
C.			
M.			
M.			
K.			
Mz.			
Mq.			
V.			
S.			
S.			
A.			
R.			
PE.			
G.			
T.D.			

Loc. in Sec. _____
NW NE SE

Geol. _____
 Contr. _____

Pool _____

Pierce

FIRST REPORT		
	0	
	SEPT 4 '55	

Date Comm. 9/13/55, Spudding

Co. Lse. No. Sec. T. R.

