


Section 21 Township 25 Range 4E

Well No. 1 Corfman

Company Bennett and Abel

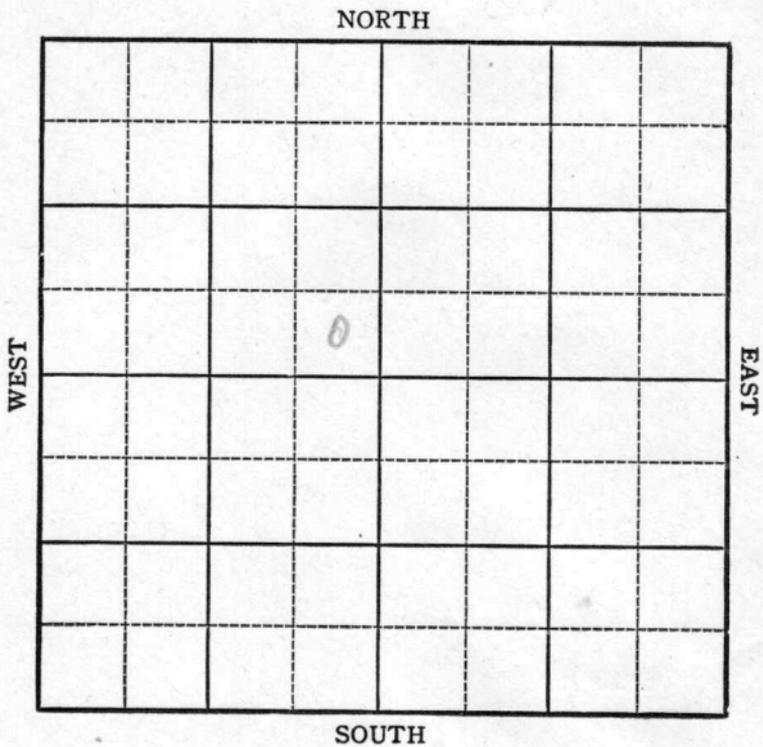

Sec. 21 Twp. 25 R. 4E

Well No. 1 Corfman Farm

Bennett and Abel Company


Miscellaneous

\_\_\_\_\_ Ft. from N. Line

330 Ft. from S. Line

480 Ft. from E. Line

\_\_\_\_\_ Ft. from W. Line

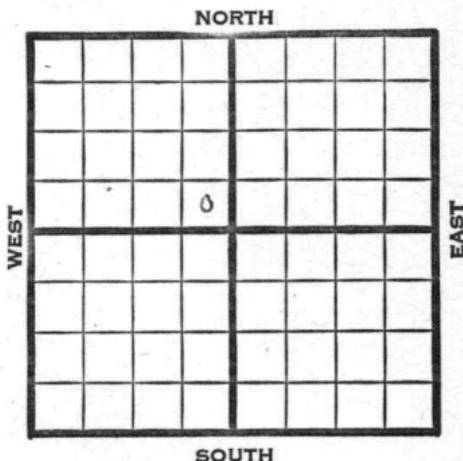

SE NW

1945

REPORT

5/16 machine

5/24 15" @ 138  
Drlg. 720

5/31 Drlg. 1450

6/8 72" @ 918 10" @ 1750 Drlg. 1880

6/20 Miss. 2566

Viola 2800

TD 2800' HFW

ABANDONED

Kansas Pool Name Miscellaneous

Map No. 14 Sec. 21 Twp. 25 R. 4E

Well No. 1 Corfman

Bennette and Abel Company

FIRST REPORT

Contractor

SE NW


SECTION PLAT

\_\_\_\_\_ Ft. from N. Line

330 Ft. from S. Line

480 Ft. from E. Line

\_\_\_\_\_ Ft. from W. Line

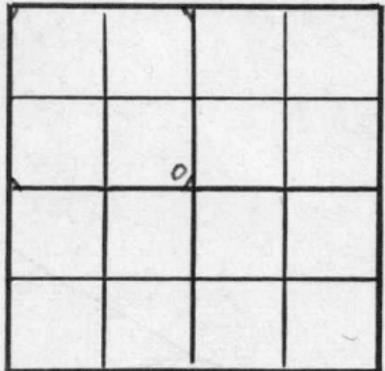

Butler

Location \_\_\_\_\_

Rig up \_\_\_\_\_

Drilling and Remarks:  
machine

RECORD

Cased \_\_\_\_\_ in., \_\_\_\_\_ ft.

Sand \_\_\_\_\_

Gas \_\_\_\_\_

Oil \_\_\_\_\_

Total Depth \_\_\_\_\_

PRODUCTION

1st 24 hrs. Nat. \_\_\_\_\_

1st 24 hrs. after shot \_\_\_\_\_

Gas \_\_\_\_\_ Cu. Ft.

Dry Hole \_\_\_\_\_

Abandoned \_\_\_\_\_

Date

MAY 1 6 1945

19

S. J. LEWIS

Scout

Kansas Pool Name Miscellaneous

Map No. \_\_\_\_\_ Sec. 21 Twp. 25 R. 4E

Well No. 1 Corfman

Bennett and Abel Company

**ABANDONED**

Contractor \_\_\_\_\_

SE NW

**SECTION PLAT**

		0	

\_\_\_\_\_ Ft. from N. Line

330 Ft. from S. Line

480 Ft. from E. Line

\_\_\_\_\_ Ft. from W. Line

Butler County

Location \_\_\_\_\_

Rig up \_\_\_\_\_

Drilling and Remarks:

*Mis 2566*  
*Vista 2800*  
*HFW*

**RECORD**

Cased \_\_\_\_\_ in., \_\_\_\_\_ ft.

Sand \_\_\_\_\_

Gas \_\_\_\_\_

Oil \_\_\_\_\_

Total Depth 2800

**PRODUCTION**

1st 24 hrs. Nat. \_\_\_\_\_

1st 24 hrs. after shot \_\_\_\_\_

Gas \_\_\_\_\_ Cu. Ft.

Dry Hole \_\_\_\_\_

Abandoned \_\_\_\_\_

Date

JUN 20 1945 19

S. J. LEWIS Scout