


Section 21 Township 25 Range 4E
Well No. #2 Corfman
Company Adair

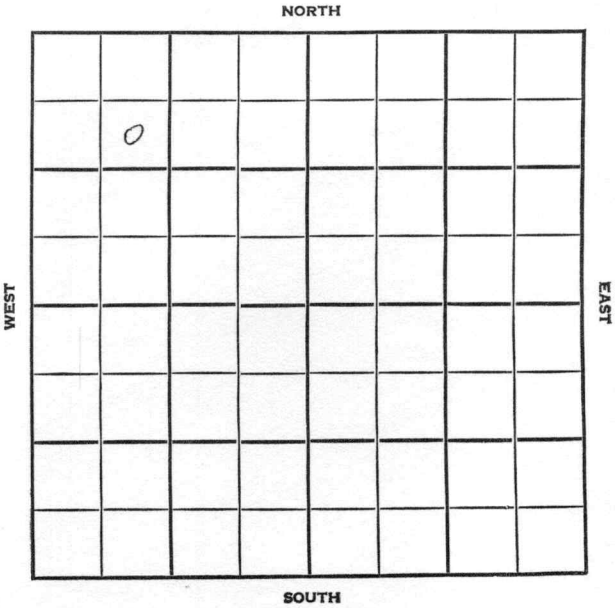

SEC. 21	TWP. 25	R. 4E
------------	------------	----------

WELL NO.

#2 Corfman

FARM

COMPANY

Adair

CONTRACTOR

Co. Tools

NW Pierce


____ FT. FROM N. LINE

____ FT. FROM S. LINE

____ FT. FROM E. LINE

____ FT. FROM W. LINE

SE NW NW

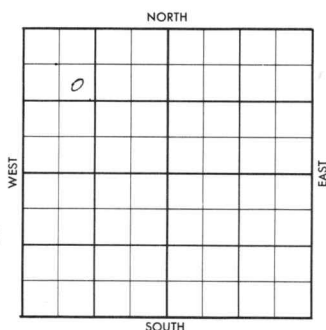

1956

ELEVATION

1358'

REPORT

6-13

Comm. 6-8-56

Drlg. 1163

7-11

4 1/2" @ 2589 w/50

DD 2591

B/ 1 GO, no/wtr.

DD 2594

B/ 1/2 BOPH, no/wtr.

tst 10 BFPH, 75% wtr.,

S/ 11 BFPH, 75% wtr., 8 hrs.

P/ 25 BO / 75% wtr.

KC. 2150'; BKC 2311'; M.Chert 2587';

TD 2589'

COMPLETED

County Butler Elev. _____
 Sec. 21 Twp. 25 Rge. 4E
 Company Alair
 Farm Name Cordman No. 2

Co.

Lse.

No.

Sec.

T.

R.

TOPS	DEPTH	LOG	DATUM
Anh.			
Tr.			
H.			
Tr.			
Dg.			
Bl.			
L.			
K.C.			
B.K.C.			
Ce.			
C.			
M.			
M.			
K.			
Mz.			
Mq.			
V.			
S.			
S.			
A.			
R.			
Pe.			
G.			
T.D.			

Loc. in Sec. _____

SE NW NW

Geol. _____

Contr. _____

Co. tools

Pool _____

NW Pierce

FIRST REPORT

JUN 13 '56

Date Comm. 6-8-56

drlg. 1163

JUN 13 '56

R. G.

29

County Butler Elev. 1358
 Sec. 21 Twp. 25 Rge. 4E
 Company Adair
 Farm Name Corfman No. 2

TOPS	DEPTH	LOG	DATUM	Loc. in Sec.
Anh.				SE NW 1/4
TP.				
H.				
Tr.				
Dg.				
BL.				
L.				Geol.
K.C.	2150			Contr.
B.K.C.	2311			Co. tools
Ce.				Pool
C.				NW Pierce
M. <u>chert</u>	2587			
M.				
K.				
Mz.				
Mq.				
V.				
S.				
S.				
A.				
R.				
Pe.				
G.				
TD.	2589			

Date Comm. 6-8-56

JUL 1 1 1956

drill. 1163 JUN 20 '56 9 1/2 @ 2589/50
 JUN 27 '56 MICT DD 2591 IB 160
 no/w DD 2594 (550) JUL 3 '56
 DD 2597 TD IB 1/2 Boph
 no/w Frac tst 10 BFDh
 75% wtr & 11 BFDh 75%
 wtr 8 hrs JUL 11 '56 P. 25 B0 +
 75% wtr