


Ellsworth

Form 51-5M-11-31-Palace

Map No. _____ Sec. 26 Twp. 16 R. 10W

Well No. 1-Warnhoff Farm
Alyward et al Company

NORTH

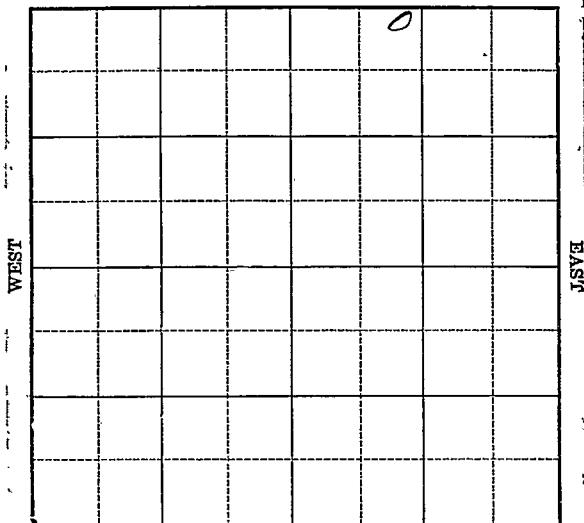

SOUTH

Location _____

Drilling Remarks _____

Rig Up _____

Drilling Remarks _____

RECORD

Cased _____ in. _____ ft.

Sand _____

Gas _____

Oil _____

Total Depth _____

PRODUCTION

1st 24 hrs. Nat. _____

1st 24 hrs. after shot _____

Gas _____ cu. ft.

Dry Hole _____

Abandoned _____

Ellsworth

Form 252-A
5M 4-32 MPC

KANSAS

Map No. _____ Sec. 26 Twp. 16 R. 10WWell No. 1- Wamhoff FarmAlyward et al Company

NORTH

330 Ft. from N. Line

_____ Ft. from S. Line

_____ Ft. from E. Line

990 Ft. from W. Line

WEST

EAST

SOUTH

Date

REPORT

19337/26 location8/2 Bldg rig8/9 spud 310'8/16 drly 950'8/22 " 1975'8/30 10" 2604 drly 2665'9/6 8" at 3060 - 6" at 3290 Top cong 3290Dep Sil 3395 TD 3400 - show oil
will acidize9/13 D. + G. 3404

ABANDONED

Edwards
 Map No. *55* Sec. *26* Twp. *16* R. *10W*
 Well No. *1-Wamhoff*
Abward et al Company
 Contractor

SECTION PLAT

330 Ft. from N. Line

..... Ft. from S. Line

..... Ft. from E. Line

990 Ft. from W. Line

			0

FIRST REPORTS

Location *✓*

Rig up *✓*

Drilling and Remarks:

RECORD

Cased.....in.,ft.

Sand.....

Gas.....

Oil.....

Total Depth.....

PRODUCTION

1st 24 hrs. Nat.....

1st 24 hrs. after shot.....

Gas.....Cu. Ft.

Dry Hole.....

Abandoned.....

Date

7/26/33 192 *O. Menschreck* Scout

Edworth
 Map No. *55* Sec. *26* Twp. *16* R. *10W*
 Well No. *1 Wamhoff*
Alyward etal Company
 Contractor

SECTION PLAT

330 Ft. from N. Line
 Ft. from S. Line
 Ft. from E. Line
990 Ft. from W. Line

		①	

ABANDONED

Location.....
 Rig up.....
 Drilling and Remarks:

N + A

RECORD.

Cased..... in. ft.
 Sand *Silicons* *3395*
 Gas.....
 Oil.....
 Total Depth *3404*

PRODUCTION

1st 24 hrs. Nat.....
 1st 24 hrs. after shot.....
 Gas..... Cu. Ft.
 Dry Hole.....
 Abandoned.....

Date

9/13/33 *O. Mannschreck* Scout